Sidywick


Form 51—5M—9-28—27423

KANSAS

Map No. Sec. 7 Twp. 26 R. 1E

Well No. 1- Roll Farm

Bu-Vi-Bar etal Company

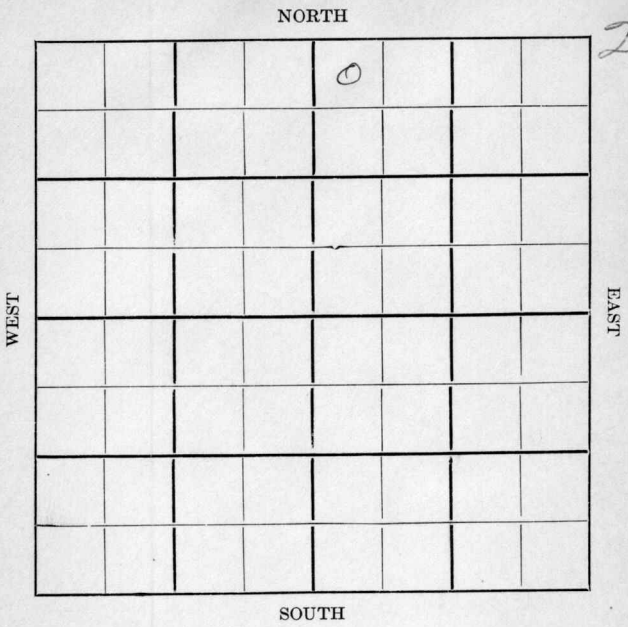

Location

Drilling Remarks

Rig Up

Drilling Remarks

RECORD

Cased in. ft.

Sand

Gas

Oil

Total Depth

PRODUCTION

1st 24 hrs. Nat.

1st 24 hrs. after shot

Gas cu. ft.

Dry Hole

Abandoned

Sedgwick

FORM 252A-5M-12-28-PETROL

Map No. KANSAS Sec. 7 Twp. 26 R. 1E

Well No. 1 Roll Farm


Bu-Vi-Bar Pet Company

304 Ft. from N. Line

_____ Ft. from S. Line

_____ Ft. from E. Line

240 Ft. from W. Line

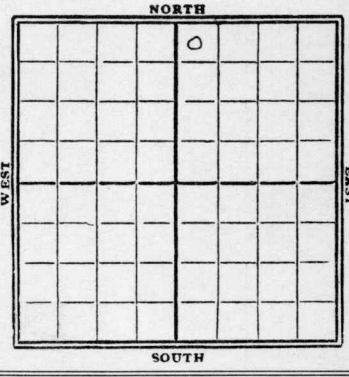

1929

Date	REPORT
1/23	Location
1/30	Cellar
2/6	
2/13	Rig
2/20	Spud 60'
2/27	drlg 860'
3/6	" 1515'
3/13	" 2205'
3/20	" 2610'
3/27	" 3015'
4/3	" 3085'
4/10	drlg 3290 Base Miss. 3262
4/17	Simp 3367-74 431 bbls in 5 hrs
4/24	Simp sand 3367-74 T.D. 3374 swab 888 bbl oil Comp.

FORM 26 250 BKS. 4-28 WESTERN

Sedgwick

MAP NO. KANSAS SEC. 7 TWP. 26 R. 1E


K13

WELL NO. 1 Rolf

Bu-Vi-Bar & Dale COMPANY

CONTRACTOR

SECTION PLAT

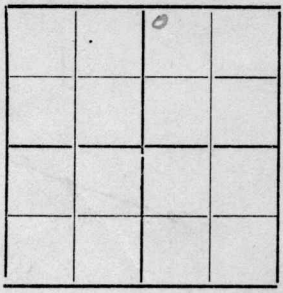

304 FT. FROM N. LINE

FT. FROM S. LINE

FT. FROM E. LINE

240 FT. FROM W. LINE

FIRST REPORTS

LOCATION

RIG UP

DRILLING AND REMARKS:

RECORD

CASED IN., FT.

SAND

GAS

OIL

TOTAL DEPTH

PRODUCTION

1ST 24 HRS. NAT.

1ST 24 HRS. AFTER SHOT

GAS CU. FT.

DRY HOLE

ABANDONED

DATE

JAN 23 1929

192

S. J. LEWIS SCOUT

Form 26 1M Bks. 9-28

Map No. KANSAS Sec. 7 Twp. 26 R. 15E


13

Well No. 1 Rolle

Bu Vi Bar Edal Company

Contractor

SECTION PLAT

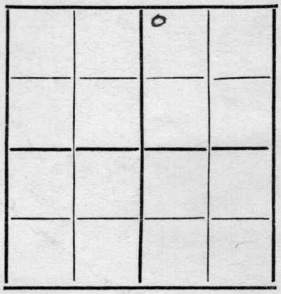

304 Ft. from N. Line

Ft. from S. Line

Ft. from E. Line

240 Ft. from W. Line

COMPLETED

Location

Rig up

Drilling and Remarks:

Simpson Sand

3367 to 74

Swab 5 BO 7 Hrs

RECORD

Cased in., ft.

Sand

Gas

Oil

Total Depth 3374

PRODUCTION

1st 24 hrs. Nat.

1st 24 hrs. after shot

Gas Cu. Ft.

Dry Hole

Abandoned

Date

APR 24 1929 192

S. J. LEWIS Scout