

KANSAS

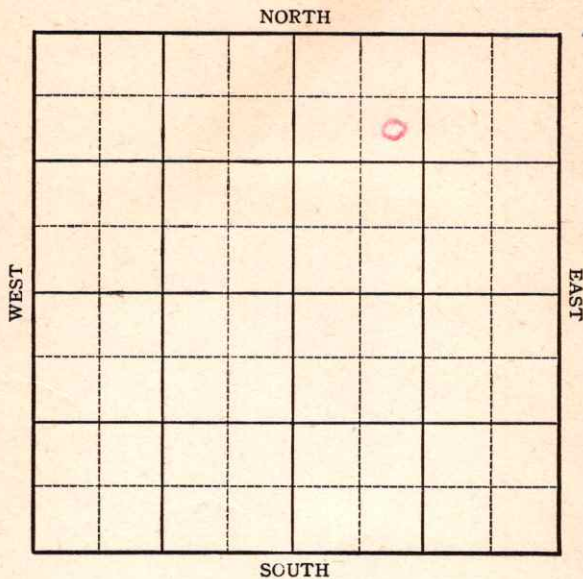
BARTON

FORM 51 5M 11-44 PETROL

Section 4 Township 18 S Range 14 W

Well No. #3 Reidel

Company CONTINENTAL ETAL



KANSAS

Barton County

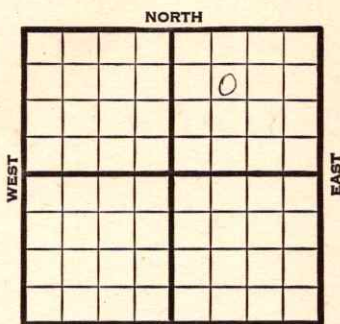
Sec. 4 Twp. 18 R. 14WWell No. #3 Reidel Farm
Continental et al Company

Boyd

990 Ft. from N. Line

Ft. from S. Line

Ft. from E. Line

990 Ft. from W. Line

SE NW NE Elev. 1943

SOUTH

1945

REPORT

4/11 Location
4/20 256 Run 13"
4/27 13" @ 256
8" @ 871' WOC
5/3 Drlg. 2550
5/10 Drlg. 3178
5/17 Arb 3446-3454
TD 3454
6" @ 3448' RUST
5/24 Lans 3207
Arb 3440 corrected
6" @ 3442
TD 3452
5/31 36 shots 3395-3410 no shows
28 shots 3337-3345 no shows
46 shots 3274-3294 25 gals. Wtr.
Trace oil
6/13 Arb 3440
6" @ 3442'
TD 3452'

ABANDONED

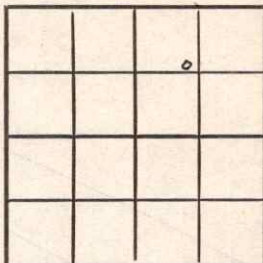
Pool Name Boyd

Kansas

Map No. 13 Sec. 4 Twp. 18 R. 14WWell No. 3 ReidelContinental etal CompanyFIRST REPORT Contractor

SE NW NE

SECTION PLAT

990 Ft. from N. Line Ft. from S. Line Ft. from E. Line990 Ft. from W. LineBartonLocation XRig up

Drilling and Remarks:

RECORD

Cased in., ft.Sand Gas Oil Total Depth

PRODUCTION

1st 24 hrs. Nat. 1st 24 hrs. after shot Gas Cu. Ft.Dry Hole Abandoned

Date

APR 1 1 1945

19

S. J. LEWIS

Scout

Kansas Pool Name BoydMap No. 73 Sec. 4 Twp. 18 R. 14WWell No. 3 ReidelContinental etal Company**ABANDONED**

Contractor

SE NW NE

2/1/1943**SECTION PLAT**990 Ft. from N. Line Ft. from S. Line Ft. from E. Line990 Ft. from W. Line

		o	

Barton CountyLocation Rig up

Drilling and Remarks:

Per 834406 "C 3442**RECORD**Cased in., ft.Sand Gas Oil Total Depth 3432**PRODUCTION**1st 24 hrs. Nat. 1st 24 hrs. after shot Gas Cu. Ft.Dry Hole Abandoned

Date

JUN 13 1945 19S. J. LEWIS Scout