


Section 21 Township 31 Range 4-E

Well No. #3 Waite

Company A.D.Barnett et al

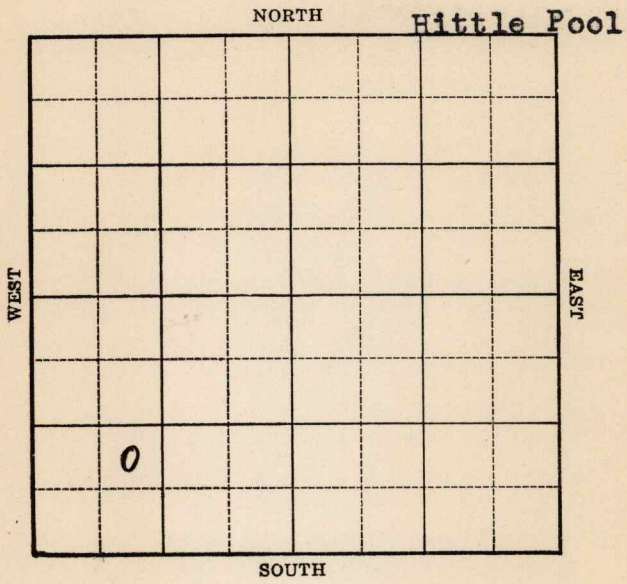

Map No. _____ Sec. **21** Twp. **31** R. **4E**

Well No. **3 Waite**

A. D. Barnett etal Company

Contractor

FIRST REPORT

SECTION PLAT

NE SW SW,

_____ Ft. from N. Line

990 Ft. from S. Line

_____ Ft. from E. Line

990 Ft. from W. Line

o			

HITTLE POOL

Location _____

Rig up _____

Drilling and Remarks:

Rotary

RECORD

Cased _____ in., _____ ft.

Sand _____

Gas _____

Oil _____

Total Depth _____

PRODUCTION

1st 24 hrs. Nat. _____

1st 24 hrs. after shot _____

Gas _____ Cu. Ft.

Dry Hole _____

Abandoned _____

Date

MAY 31 1920 19 _____

S. J. LEWIS Scout

Map No. 2 Sec. 21 Twp. 31 R. 4E

Well No. 3 Waite

A. D. Barnett etal Company

Contractor

COMPLETED

SECTION PLAT

NE SW SW

_____ Ft. from N. Line

990 Ft. from S. Line

_____ Ft. from E. Line

990 Ft. from W. Line

HITTLE POOL

o			

Location _____

Rig up _____

Drilling and Remarks:

CR 83322.

7" @ 3318.

Bottom hole bomb

Per 4770

RECORD

Cased _____ in., _____ ft.

Sand _____

Gas _____

Oil _____

Total Depth 3821

PRODUCTION

1st 24 hrs. Nat. _____

1st 24 hrs. after shot _____

Gas _____ Cu. Ft.

Dry Hole _____

Abandoned _____

Date

JUN 21 1939 19

S. J. LEWIS Scout