


KANSAS

Barton

Section 4 Township 18 Range 14W

Well No. #2 F. Riedel

Company Continental et al

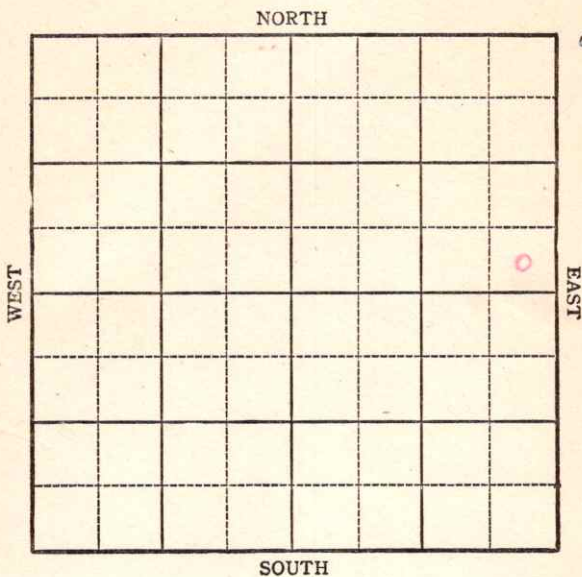

KANSAS

Barton

Sec. 4 Twp. 18 R. 14W

Well No. #2 F. Riedel Farm


Continental et al Company
Boyd

 Ft. from N. Line

330 Ft. from S. Line

330 Ft. from E. Line

 Ft. from W. Line

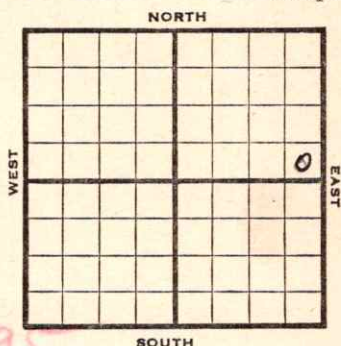

SE NE Elev. 1895

1945 R E P O R T

1/24	Derrick
1/31	Drlg. 220'
2/7	15 @ 243 8" @ 856 WOC
2/14	Drlg 2380
2/21	Drlg 2790
2/28	Drlg 3166
3/7	Arb 3357-68 TD 6" @ 3360 RUST
3/14	Lans 3144 TD 3376 Swab 118 oil in 3 hrs 1000 acid
3/21	Arb 3357 6" @ 3360 1000 acid TD 3376' Pump 330 Pot. Grav. 38.0

COMPLETED

Pool Name BoydMap No. 73 Sec. 4 Twp. 18 R. 14WWell No. 2 F. RiedelContinental etal CompanyFIRST REPORT Contractor

SE NE

SECTION PLAT

 Ft. from N. Line330 Ft. from S. Line330 Ft. from E. Line Ft. from W. Line

			o

BartonLocation Rig up Drilling and Remarks:
derrick

RECORD

Cased in., ft.Sand Gas Oil Total Depth

PRODUCTION

1st 24 hrs. Nat. 1st 24 hrs. after shot Gas Cu. Ft.Dry Hole Abandoned


Date

JAN 24 1945 19 S. J. LEWIS Scout

Pool Name BoydMap No. 23 Sec. 4 Twp. 18 R. 14WWell No. 2 F. RiedelContinental etal CompanyCOMPLETED Contractor

SE NE

SECTION PLAT

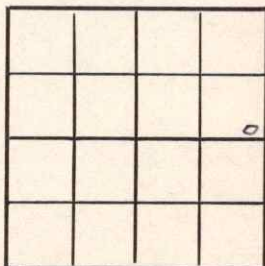 Ft. from N. Line330 Ft. from S. Line330 Ft. from E. Line Ft. from W. LineBarton CountyLocation Rig up

Drilling and Remarks:

*Ar 8357**6" @ 3360**1000 cu ft**Pump 330 ft.**382 ft*

RECORD

Cased in., ft.Sand Gas Oil Total Depth 3376

PRODUCTION

1st 24 hrs. Nat. 1st 24 hrs. after shot Gas Cu. Ft.Dry Hole Abandoned

Date

MAR 21 1945 19S. J. LEWIS

Scout