KANSAS


FORM 51 5M PETROL

Barton

Section 4 Township 18 Range 14 W

Well No. #1 F. V. Riedel

Company Continental & Phillips

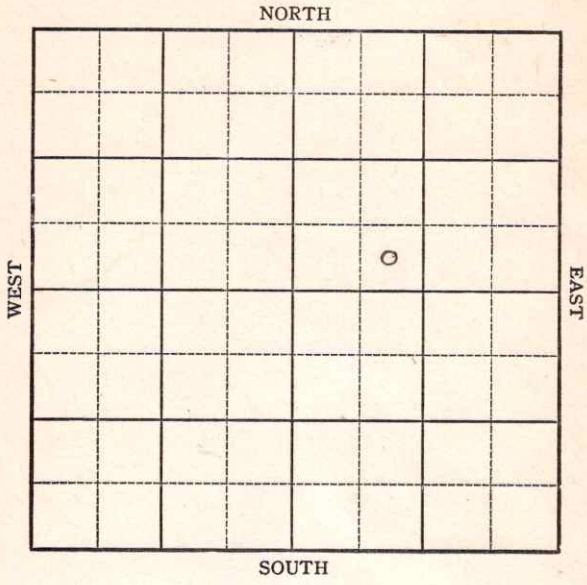


FORM 252-A
5M 9-43 GASS KANSAS

Barton

Sec. 4 Twp. 18 R. 14-W

Well No. #1 F. V. Riedel Farm

Continental & Phillips Company

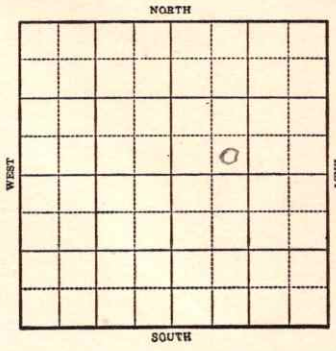

_____ Ft. from N. Line

330 Ft. from S. Line

_____ Ft. from E. Line

990 Ft. from W. Line

1943	Elev. 1936 REPORT
12/1	Derrick
12/8	8" @ 113 Drlg. 255'
12-15	10" at 249' 8 at 921' WOC
12/22	Drlg. 953
12/29	Drlg 2930'
1944 1-5	Arb 3398 TD 3408 6" @ 3399 RUST
1-12	Arb 3405 corrected 6" @ 3406 TD 3419 100' oil 14 hrs.
1/19	TD 3424-2700' oil
1/21	500 acid.
2/2	Swb 40 oil in 2 hrs.
2/8	" " " "
2/15	" " "
2/23	" " "
3/1	" " "
3/8	" " "
3/16	" " "
3/22	" " "

OVER

1944

3/22 Swb 40 oil in 2 hrs.

3/29 6" @ 3406
TD 3424
500 acid
Arb. 3398
Pump 435 Pot.
Gravity 36.9

COMPLETED

Form 26 200 Bks 5-42 Petrol Barton

KANSAS

Map No. 73 Sec. 4 Twp. 18 R. 14W


Well No. 1 F. V. Riedel

Continental & Phillips Company

FIRST REPORT Contractor

SE SW NE

SECTION PLAT

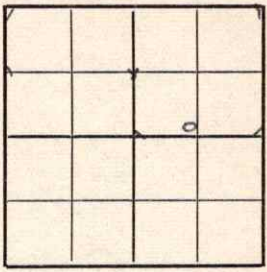

____ Ft. from N. Line

330 Ft. from S. Line

____ Ft. from E. Line

990 Ft. from W. Line

Boyd Pool

Location

Rig up

Drilling and Remarks:

Derrick

RECORD

Cased ____ in., ____ ft.

Sand

Gas

Oil

Total Depth

PRODUCTION

1st 24 hrs. Nat.

1st 24 hrs. after shot

Gas ____ Cu. Ft.

Dry Hole

Abandoned

Date

DEC 1 1943 19

S. J. LEWIS Scout

Form 26 200 Bks 5-42 Petrol

Barton

KANSAS

Map No. 73 Sec. 4 Twp. 18 R. 14W


Well No. 1 F. V. Riedel

Continental & Phillips Company

COMPLETED Contractor

SE SW NE

SECTION PLAT

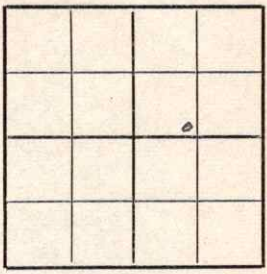

____ Ft. from N. Line

330 Ft. from S. Line

____ Ft. from E. Line

990 Ft. from W. Line

Boyd Pool

Location

Rig up

Drilling and Remarks:

Cir Y3398'.
6' C3406
500 and
Pump 435 Bbl.

36# Gr

RECORD

Cased ____ in., ____ ft.

Sand

Gas

Oil

Total Depth 3424

PRODUCTION

1st 24 hrs. Nat.

1st 24 hrs. after shot

Gas ____ Cu. Ft.

Dry Hole

Abandoned

Date

MAR 2 9 1944 19 S. J. LEWIS Scout