


Section 21 Township 31 Range 4-E

Well No. 4 Waite

Company Hartman & Blair

Hittle Pool

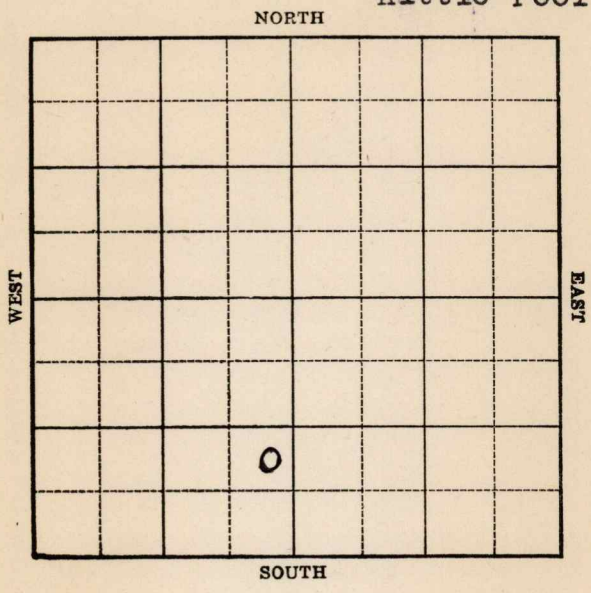

Cowley

Map No. 2 Sec. 21 Twp. 31 R. 4EWell No. 4 WaiteHartman & Blair

Company

Contractor

FIRST REPORT

NE SE SW

 Ft. from N. Line990 Ft. from S. Line250 Ft. from E. Line Ft. from W. Line

SECTION PLAT

	0		

HITTLE POOL

Location Rig up

Drilling and Remarks:

RR

RECORD

Cased in., ft.Sand Gas Oil Total Depth

PRODUCTION

1st 24 hrs. Nat. 1st 24 hrs. after shot Gas Cu. Ft.Dry Hole Abandoned

Date

MAR 15 1939

19

E. D. Hatfield

Scout

Cowley

KANSAS

Map No. 2 Sec. 21 Twp. 31 R. 4EWell No. 4 WaiteHartman & Blair

Company

Contractor

COMPLETED

NE SE SW

SECTION PLAT

	0		

 Ft. from N. Line990 Ft. from S. Line250 Ft. from E. Line Ft. from W. Line

HITTLE POOL

Location Rig up

Drilling and Remarks:

P-2315/8

Pot 6945

RECORD

Cased 7 in., 3259 ft.Sand Arb 3273Gas Oil Total Depth 3277

PRODUCTION

1st 24 hrs. Nat. 1st 24 hrs. after shot Gas Cu. Ft.Dry Hole Abandoned

Date

APR 5 - 1939

19

H. D. Hatfield

Scout