

KANSAS


Cowley

Form 51—5M—11-38—Palace

Section 21 Township 31 Range 4-E


Well No. #5 Waite

Company Barnett & Connley

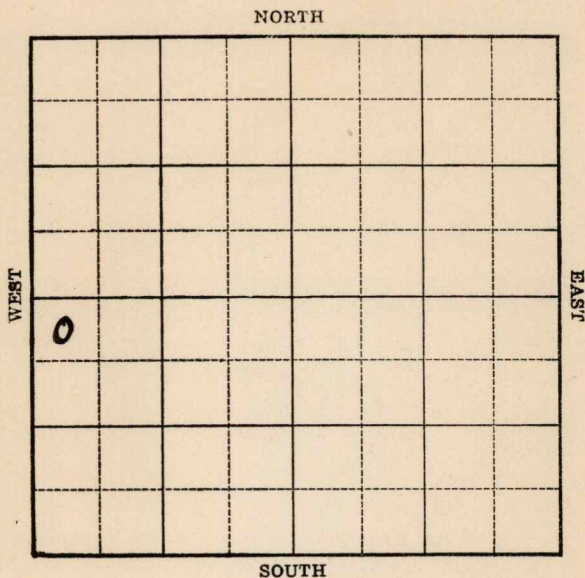

KANSAS

Cowley

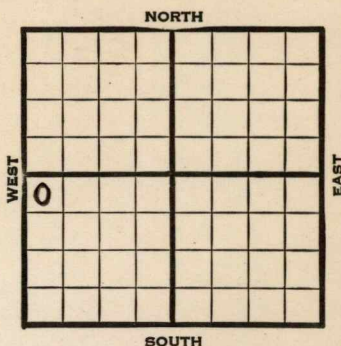Sec. 21 Twp. 31 R. 4-EWell No. #5 Waite FarmBarnett & Connley Company
(Hittle)330 Ft. from N. Line Ft. from S. Line Ft. from E. Line330 Ft. from W. Line

Elev. 1251

1939	REPORT
7/19	Rotary.
7/27	Rigging up.
8/3	10" - 96' Drlg. 2345'
8/10	K. C. 2432' Drlg. 3320'
8/16	Arb. 3376'
	5" - 3370'
	T.D. 3380½'
	Bottom hole pressure bomb poten.
	1455 bbls.
	COMPLETED

Cowley

KANSAS

Map No. 2 Sec. 21 Twp. 31 R. 4EWell No. 5 WaiteBarnett & Connley

Company

Contractor

FIRST REPORT

SECTION PLAT

NW SW

330 Ft. from N. Line Ft. from S. Line Ft. from E. Line330 Ft. from W. Line

0			

HITTLE POOL

Location Rig up

Drilling and Remarks:

Rotary ,

RECORD

Cased in., ft.Sand Gas Oil Total Depth

PRODUCTION

1st 24 hrs. Nat. 1st 24 hrs. after shot Gas Cu. Ft.Dry Hole Abandoned

Date

JUL 19 1939 19

S. J. LEWIS

Scout

Cowley

KANSAS

Map No. 2 Sec. 21 Twp. 31 R. 4EWell No. 5 WaiteBarnett & Connley

Company

Contractor

COMPLETED

NW SW

330 Ft. from N. Line Ft. from S. Line Ft. from E. Line330 Ft. from W. Line

HITTLE POOL

SECTION PLAT

0			

Location Rig up

Drilling and Remarks:

*Cr & 3376**5" @ 3370**Bottom Hole Pressure**Bon & 1455*

RECORD

Cased in., ft.Sand Gas Oil Total Depth 3380 1/2

PRODUCTION

1st 24 hrs. Nat. 1st 24 hrs. after shot Gas Cu. Ft.Dry Hole Abandoned

Date

AUG 16 1939

19

S. J. LEWIS

Scout