Form 51—5M—11-38—Palace

Cowley

KANSAS

Section 21 Township 31 Range 4-E

Well No. #6 Waite

Company Barnett & Connelly

Hattle Pool

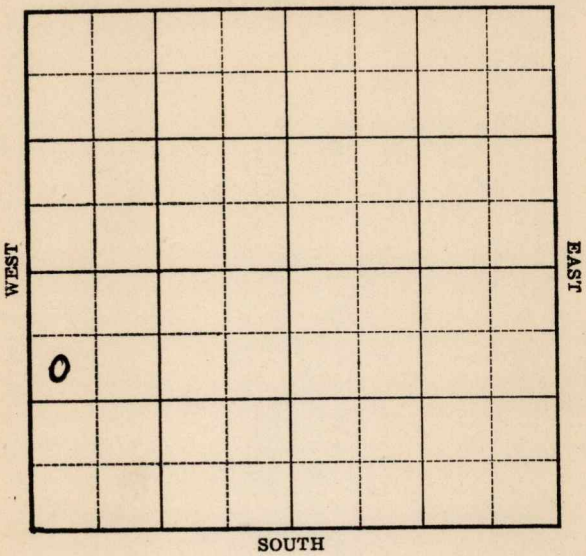

FORM 252-A 5M 4-39 KANSAS Cowley

Sec. 21 Twp. 31 R. 4-E

Well No. #6 Waite Farm

Barnett & Connelly Company

(Hittle)

990 Ft. from N. Line

Ft. from S. Line

Ft. from E. Line

330 Ft. from W. Line

Elev. 1249

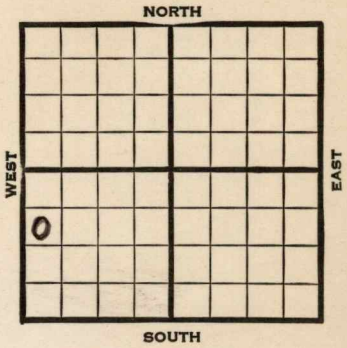

1939	REPORT
7/12	10" - 90' Drlg. 2230'
7/20	Chat. 3031' Drlg. 3124'
7/27	Arb. 3376' T.D. 3382'
	Flow 21 bbls. per hour.
8/2	Arb. 3376'
	T. D. 3382'
	5½" - 3359'
	Bottom hole pressure bomb
	potential 967 bbls.
	COMPLETED

Form 26—1M Bks.—2-29

Cowley KANSAS

Map No. 2 Sec. 21 Twp. 31 R. 4E

Well No. 6 Waite

Barnett & Connelly Company

Contractor

FIRST REPORT

SW NW SW

990 Ft. from N. Line

Ft. from S. Line

Ft. from E. Line

330 Ft. from W. Line

HITTLE POOL

SECTION PLAT

o			

Location

Rig up

Drilling and Remarks:

10" - 90

Drlg. 2230

RECORD

Cased in., ft.

Sand

Gas

Oil

Total Depth

PRODUCTION

1st 24 hrs. Nat.

1st 24 hrs. after shot

Gas Cu. Ft.

Dry Hole

Abandoned

Date

JUL 12 1939

19

S. J. LEWIS Scout

Form 26—1M Bks.—2-29 Cowley KANSAS

Map No. 2 Sec. 21 Twp. 31 R. 4E

Well No. 6 Waite

Barnett & Connelly Company

Contractor

COMPLETED

SW NW SW

990 Ft. from N. Line

Ft. from S. Line

Ft. from E. Line

330 Ft. from W. Line

HITTLE POOL

SECTION PLAT

o			

Location

Rig up

Drilling and Remarks:

Cir & 3376

5½" @ 3359

Bottom Hole Pe.

Bom & 967 Pd.

RECORD

Cased in., ft.

Sand

Gas

Oil

Total Depth 3382

PRODUCTION

1st 24 hrs. Nat.

1st 24 hrs. after shot

Gas Cu. Ft.

Dry Hole

Abandoned

Date

AUG 2 1939 19

S. J. LEWIS Scout