

KANSAS

Cowley


Form 51-5M-11-38-Palace

Section 21 Township 31 Range 4-E

Well No. 8 Waite

Company Hartman & Blair

NORTH Hittle Pool

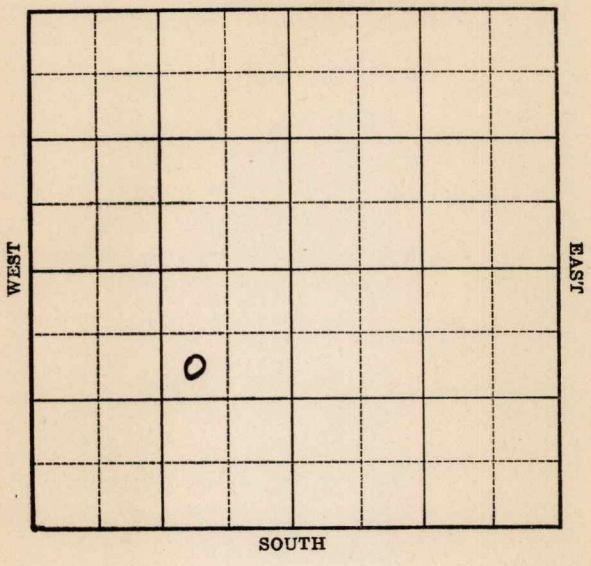

Sec. 21 Twp. 31 R. 4-E

Well No. #8 Waite Farm

Hartman & Blair Company

(Hittle)


990 Ft. from N. Line

_____ Ft. from S. Line

990 Ft. from E. Line

_____ Ft. from W. Line

Elev. 1229

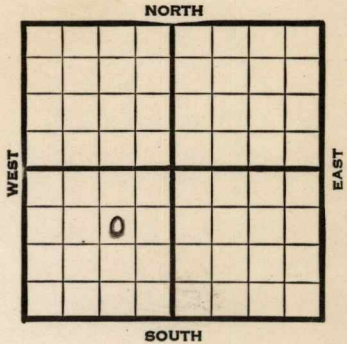

1939	REPORT
5/24	Cellar.
6/1	10" - 90' Drlg. 632'
6/8	Drlg. 2945'
6/16	Miss. 2998' 7" - 3000' RUST.
6/23	Base Miss. 3240' Arb. 3320'
	T.D. 3334' Flow 250 bbls. per hour.
6/28	Arb. 3320'
	7" - 3300'
	T.D. 3334'
	Bottom hole pressure bomb
	potential 7170 bbls.
	Maximum 3500 bbls.
	COMPLETED

Cowley **KANSAS**

Map No. 2 Sec. 21 Twp. 31 R. 4E

Well No. 8 Waite

Hartman & Blair Company

Contractor

FIRST REPORT

SECTION PLAT

SW NE SW

990 Ft. from N. Line

_____ Ft. from S. Line

990 Ft. from E. Line

_____ Ft. from W. Line

	o		

HITTLE POOL

Location _____

Rig up _____

Drilling and Remarks:

Cellar

RECORD

Cased _____ in., _____ ft.

Sand _____

Gas _____

Oil _____

Total Depth _____

PRODUCTION

1st 24 hrs. Nat. _____

1st 24 hrs. after shot _____

Gas _____ Cu. Ft.

Dry Hole _____

Abandoned _____

Date

MAY 24 1939 19

S. J. LEWIS Scout

KANSAS

Cowley

Map No. 2 Sec. 21 Twp. 31 R. 4E

Well No. 8 Waite

Hartman & Blair Company

Contractor

COMPLETED

SECTION PLAT

SW NE SW

990 Ft. from N. Line

_____ Ft. from S. Line

990 Ft. from E. Line

_____ Ft. from W. Line

	0		

HITTLE POOL

Location _____

Rig up _____

Drilling and Remarks:

see #3320

7" @ 3300

Bottom Hole Pr.

Bottom Pr. # 7170

*Maximum
3500*

RECORD

Cased _____ in., _____ ft.

Sand _____

Gas _____

Oil _____

Total Depth 3334

PRODUCTION

1st 24 hrs. Nat. _____

1st 24 hrs. after shot _____

Gas _____ Cu. Ft.

Dry Hole _____

Abandoned _____

Date

JUN 28 1939

19

S. J. LEWIS

Scout