

KANSAS


FORM 51 5M BRIX

Barton County

Section 5 Township 18 Range 14W

Well No. #1 Fried "A"

Company Continental et al

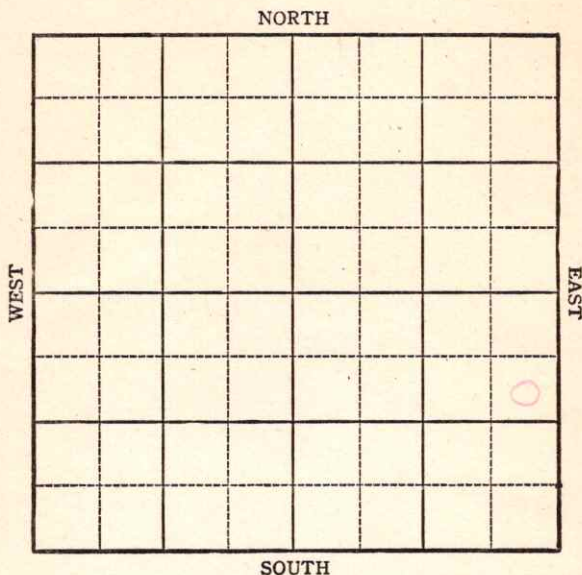

Barton County

Sec. 5 **KANSAS** Twp. 18 R. 14W

Well No. #1 Fried "A" Farm

Continental et al. Company


Boyd

990 Ft. from N. Line

 Ft. from S. Line

330 Ft. from E. Line

 Ft. from W. Line

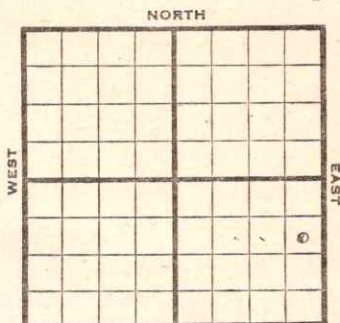

SE NE SE

Elev. 2009

1944

R E P O R T

10/11	Drk.				
10/18	RUR				
10/25	13" @ 244				
	8" @ 975 WOC				
11/2	Drlg. 2605				
11/8	Arb 3494 -96 TD				
	6" @ 3495				
11/16	" " " "				
11/24	Swb 287 oil in 7 hrs.				
11/29	" " " "				
12/6	" " " "				
12/14	" " " "				
12/21	" " " "				
12/29	" " " "				
1945					
1/3	" " " "				
1/10	" " " "				
1/17	" " " "				
1/26	" " " "				
1/31	" " " "				
2/7	" " " "				

OVER

1945

2/14

Arb. 3494

6" @ 3495

Depth Pot. 1365

TD 3496

Grav. 37.6

COMPLETED

Pool Name Boyd

KANSAS
 Map No. 735 Sec. 5 Twp. 18 R. 14W

Well No. 1 Fried "A"Continental et al.

Company

FIRST REPORT

Contractor

SE NE SE


SECTION PLAT

990 Ft. from N. Line

Ft. from S. Line

330 Ft. from E. Line

Ft. from W. Line

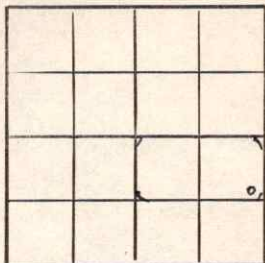Barton County

Location

Rig up

Drilling and Remarks:

Derrick**RECORD**Cased in., ft.Sand Gas Oil Total Depth **PRODUCTION**1st 24 hrs. Nat. 1st 24 hrs. after shot Gas Cu. Ft.Dry Hole Abandoned

Date

OCT 11 1944 19S. J. LEWIS

Scout

Pool Name BoydMap No. K-73 Sec. 5 Twp. 18 R. 14WWell No. 1 Fried "A"Continental etal CompanyCOMPLETED Contractor

SE NE SE

SECTION PLAT

990 Ft. from N. Line Ft. from S. Line330 Ft. from E. Line Ft. from W. LineBarton CountyLocation Rig up

Drilling and Remarks:

Cer 834946" @ 3495Dep the Rd136537 1/2

RECORD

Cased in., ft.Sand Gas Oil Total Depth 3496

PRODUCTION

1st 24 hrs. Nat. 1st 24 hrs. after shot Gas Cu. Ft.Dry Hole Abandoned

Date

FEB 14 1945 19 S. J. LEWIS Scout