

KANSAS

Barton

Section 5 Township 18 Range 14WWell No. 1 LeichtnerCompany El Capitan
Boyd Pool

NORTH

WEST

			0				

EAST

SOUTH

KANSAS

Barton

Sec. 5 Twp. 18 R. 14W

Well No. #1 Leichtner Farm

El Capitan Company

Boyd Pool


 Ft. from N. Line

330' Ft. from S. Line

330' Ft. from E. Line

 Ft. from W. Line

SE SW

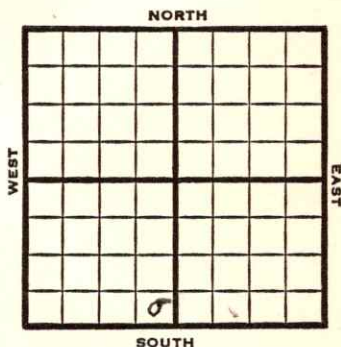

1949 **Elev 1990'** REPORT

4/20	Anhy. 963' 8" @ 974'
4/27	Lansing 3232 Drlg 3421'
5/4	Arb. 3482-85' TD 3485' 5" @ 3482' 500 acid
5/10	"
5/18	Pump 35 bbls oil a day
5/25	"
6/1	"
6/7	"
6/15	"
6/21	"
6/28	"
7/6	2000 acid
7/13	TD 3485' Arb. 3482' 5 @ 3482' 1500 Acid Pump 50 Oil Pot 36° Gr. Comp

COMPLETED

Map No. _____ Sec. 5 Twp. 18 R. 14W

Well No. 1 Leichter

El Capitan Company

FIRST REPORT Contractor

SE SW

SECTION PLAT

_____ Ft. from N. Line

330 Ft. from S. Line

330 Ft. from E. Line

_____ Ft. from W. Line

Barton County

Location _____

Rig up _____

Drilling and Remarks:

Anhy 963

8" @ 974

RECORD

Cased _____ in., _____ ft.

Sand _____

Gas _____

Oil _____

Total Depth _____

PRODUCTION

1st 24 hrs. Nat. _____

1st 24 hrs. after shot _____

Gas _____ Cu. Ft.

Dry Hole _____

Abandoned _____

Date

APR 20 1949 19

S. J. LEWIS Scout

Kansas

Map No. K73 Sec. 5 Twp. 18 R. 14WWell No. 1 LeichtnerEl Capitan

Company


COMPLETE

Contractor

SE SW

E11990
SECTION PLAT Ft. from N. Line330 Ft. from S. Line330 Ft. from E. Line Ft. from W. Line

Barton County

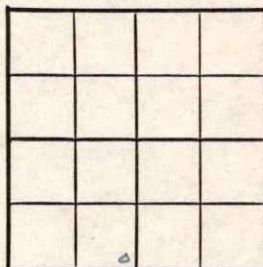Location Rig up

Drilling and Remarks:

Art 34825" C 34821500 acidPump Oil Port36 1/4**RECORD**Cased in., ft.Sand Gas Oil Total Depth 3485**PRODUCTION**1st 24 hrs. Nat. 1st 24 hrs. after shot Gas Cu. Ft.Dry Hole Abandoned

Date

JUL 13 1949

19

S. J. LEWIS

Scout