

Cowley

Map No. _____ Sec. 21 Twp. 31 R. 4

Well No. 2 - Little Farm _____


Texas Co Company _____

1020 Ft. from N. Line

_____ Ft. from S. Line

_____ Ft. from E. Line

1020 Ft. from W. Line

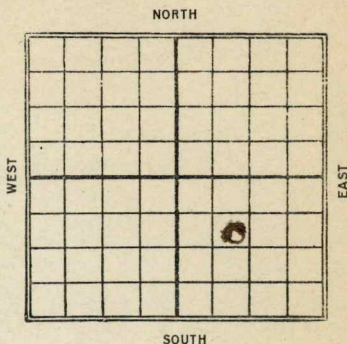

1927

Date	REPORT
6/16	Location
6/22	Timbers
6/29	Bldg rig
7/7	Spudding
7/13	Drilg 450'
7/20	" 1050
7/28	" 1470
8/4	" 1850'
8/10	" 2000
8/18	" 2250'
8/24	" 2250
9/1	Top Sand 2387- Oil 2411-17- T.D. 2418- 1200' oil in hole.
9/7	2387-2418 T.D. 2418 Oil 2411-17 10/140 bbl

Cowley

Map No. 2 **KANSAS** Sec. 21 Twp. 31 R. 4

Well No. 2 Little

Texaco Co

Company

Contractor

FIRST REPORTS

SECTION PLAT

1020 Ft. from N. Line

----- Ft. from S. Line

----- Ft. from E. Line

1020 Ft. from W. Line

		o	

Location

Rig up -----

Drilling and Remarks:

RECORD

Cased ----- in., ----- ft.

Sand -----

Gas -----

Oil -----

Total Depth -----

PRODUCTION

1st 24 hrs. Nat. -----

1st 24 hrs. after shot -----

Gas ----- Cu. Ft.

Dry Hole -----

Abandoned -----

Date

JUN 16 1927

192

CHAS. L. SHERWOOD

Scout

Cowley

Map No. 2 **KANSAS** Sec. 21 Twp. 31 R. 4

Well No. 2 *Little*

Texas Co Company

Contractor

COMPLETED

SECTION PLAT

1070 Ft. from N. Line

----- Ft. from S. Line

----- Ft. from E. Line

1020 Ft. from W. Line

		o	

Location -----

Rig up -----

Drilling and Remarks:

oil 2411-17'

109 140 Bl.

RECORD

Cased ----- in., ----- ft.
 Sand 2387-2418
 Gas -----
 Oil -----
 Total Depth 2418

PRODUCTION

1st 24 hrs. Nat. -----
 1st 24 hrs. after shot -----
 Gas ----- Cu. Ft.
 Dry Hole -----
 Abandoned -----

Date

SEP 7 - 1927

CHAS. L. SHERWOOD