


Barton

KANSAS

SECTION 5 TOWNSHIP 18 RANGE 14W

WELL NO. #1 Mantz

COMPANY Birmingham-Bartlett

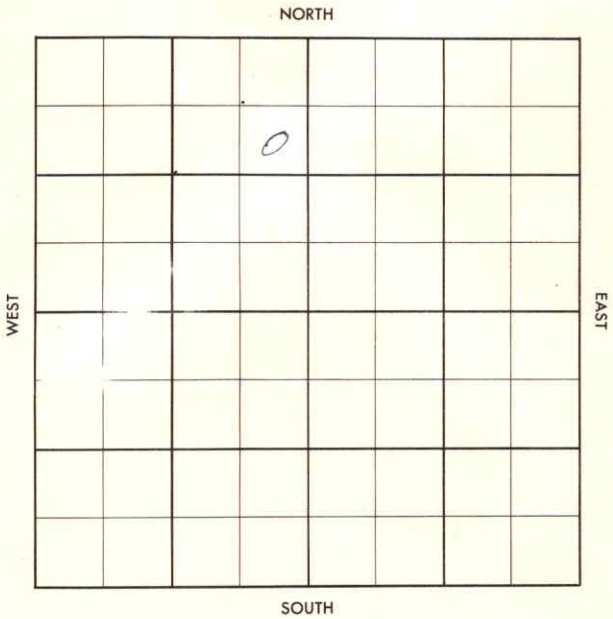

Barton

KANSAS

SEC.

5

TWP.

18

R.

14W

WELL NO.

#1 Mantz

FARM

COMPANY

Birmingham-Bartlett

CONTRACTOR

Co Tools

Boyd


____ FT. FROM N. LINE

____ FT. FROM S. LINE

____ FT. FROM E. LINE

____ FT. FROM W. LINE

SE NE NW

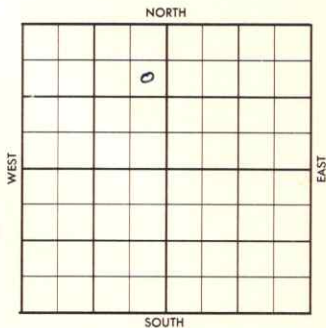

ELEVATION

1956

REPORT

9-12

Comp 9-9-56

8" @ 605

Drlg 905

County Barton Elev. _____
 Sec. 5 Twp. 18 Rge. 14W
 Company Birmingham-Bartlett
 Farm Name Mantz No. 1

TOPS	DEPTH	LOG	DATUM	Loc. in Sec.
Anh.				SE NE NW
Tp.				
H.				
Tr.				
Dg.				
Bl.				
L.				Geol.
K.C.				Contr.
B.K.C.				Co. Tools
Ce.				Pool
C.				Boyd
M.				
M.				
K.				
Mz.				
Mo.				
V.				
S.				
S.				
A.				
R.				
Pf.				
G.				
T.D.				

Geol.

Contr.

Co. Tools

Pool

Boyd

SEP 12 56

FIRST REPORT

Date Comm. 9/9/56

8" @ 605, Drlg. 905

SEP 11 1956

SEP 11 1956

SEP 11 1956

County Ed. Co. Elev. 1941 RB
 Sec. 5 Twp. 18 Rge. 14W 1938 DE
 Company Birmingham-Bartlett
 Farm Name Nantz No. 1

TOPS	DEPTH	LOG	DATUM	Loc. in Sec.
Anh.	927			SE NE NW
TP.				
H.	3111			
Tr.				
Dg.				
Bl.	3174			
L.	3186			Geol.
N.C.				
B.K.C.				Contr.
Ce.				Co. Tools
C.	3402			
M.				Pool
M.				
K.				Boyd
Mz.				
Mo.				
V.				
S.				
S.				
A.	3445			
R.				
PE.				
G.				
TD.	3453			

OCT 3 '56

Date Comm. 9/9/58

8" 605. Drlg. 905 SEP 19 '56

DST 3180-96 1hr G/14" 540'
oil + 15' SW BHP 1000/15"
DST 3197-3211 1hr rec 330' SW
BHP 930/15" ϕ 3249 SEP 26 '56
DST 3263-85 1hr rec 60' WM
BHP 740 5 1/2 @ 3447 / CO DD
3457 1/2, tst 4 BSWph PB
OCT 9 '56 PB 3282 20/3185-90

1/2 2 1/2 B0 not with 30"
1/2 11 B0ph not with 10
new P. 50 B0pd not with