

Barton

KANSAS

Section 5 Township 18 Range 14WWell No. #1 MantzCompany Rockett Drlg.

NORTH

			0				

WEST

EAST

SOUTH

Barton

KANSAS

Sec. 5 Twp. 18 R. 14W

Well No. #1 Mantz Farm ✓

Rockett Drlg.

Company

Wildcat

Contractor

Ft. from N. Line

330

Ft. from S. Line

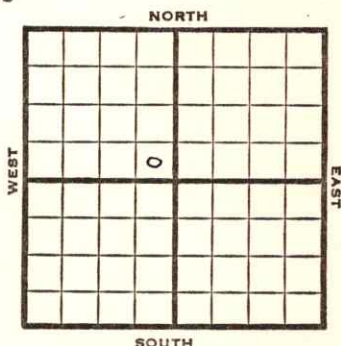
330

Ft. from E. Line

Ft. from W. Line

SE SE NW

Stanolind DHM



1951

Elev. 1967' REPORT

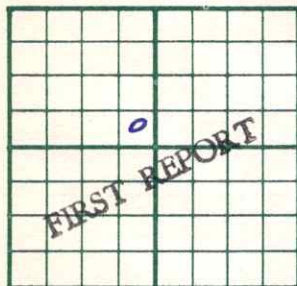
10/31

Spud 10-27-51
8" @ 1015'
Drlg. 2130'

11/14

Spud 10-27-51
D & A TD 3481' 8" @ 1015'
Anhy 959' Heeb 3157' Br lime 321'
Lans. 3226'
DST 3227-47 open 1 hr. rec 560' SW
DST 3299-3305 open 1 hr, rec 35' mud
& SW
Cong. 3444' Arb. 3478-81' TD
D & A

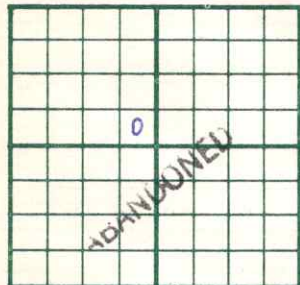
ABANDONED

County Barton State KansasSec. 5 (Blk.) 18 (Sur.) 14W Map No.Operator Rockett Drlg.Well No. 1 Farm MantzElev. Location SE SE NW330 Ft. From S Line NW330 Ft. From E Line Quarter1st. Report OCT 31 1951

Completion

Remarks Stanolind DEMSpudding Date 10-27-51Drlg. Data Wildcat8" @ 1015 Drlg. 2130

J. E. TYRA

County Barton State KansasSec. 5 (Blk.
Twp.) 18 (Sur.
Rge.) 14W Map No.Operator Rockett Drlg.Well No. 1 Farm MantzElev. 1967 Location SE SE NW330 Ft. From S Line NW330 Ft. From E Line Quarter

1st. Report

Completion NOV 14 1951Remarks WildcatSpudding Date 10-27-51Drlg. Data D & A TD 34818" @ 1015 Anhy 959 Heeb. 3157Br. lime 3217 Lans. 3226 DST 3227-47open 1 hr. Rec. 560' sw DST 3299-3305open 1 hr. Rec. 35' mud & sw Cong. 3444Arb. 3478-81 TDD & A

J. E. TYRA