


Section 21 Township 31 Range 4-E

Well No. 8 Hittle

Company Texas

NORTH Hittle Pool

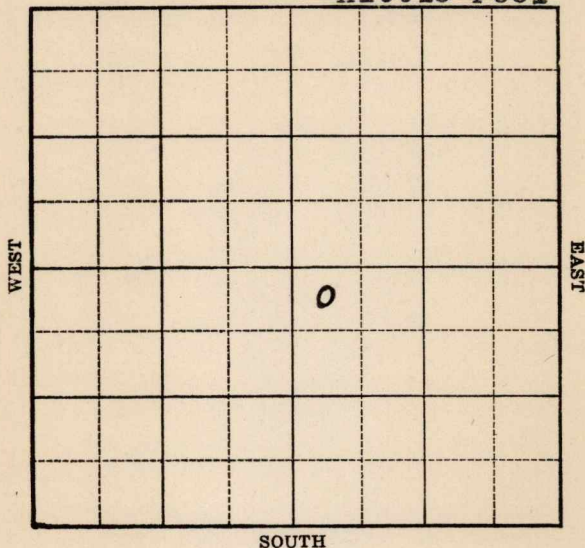

Cowley

KANSAS

Map No. 2 Sec. 21 Twp. 31 R. 4E

Well No. 8 Hittle

Texas

Company

Contractor

FIRST REPORT

SECTION PLAT

NW SE

360 Ft. from N. Line

_____ Ft. from S. Line

_____ Ft. from E. Line

245 Ft. from W. Line

		O	

HITTLE POOL

Location _____

Rig up _____

Drilling and Remarks:

BRR

RECORD

Cased _____ in., _____ ft.

Sand _____

Gas _____

Oil _____

Total Depth _____

PRODUCTION

1st 24 hrs. Nat. _____

1st 24 hrs. after shot _____

Gas _____ Cu. Ft.

Dry Hole _____

Abandoned _____

Date

FEB 8 - 1939 19

H. D. Hatfield Scout

Map No. 2 Sec. 21 Twp. 31 R. 4E

Well No. 8 Hittle

Texas

Company _____

Contractor _____

COMPLETED

NW SE

360 Ft. from N. Line

_____ Ft. from S. Line

_____ Ft. from E. Line

245 Ft. from W. Line

SECTION PLAT

		0	

HITTLE POOL

Location _____

Rig up _____

Drilling and Remarks:

Flow 1744/8

POT 5233

RECORD

Cased 7 in., 3268 ft.

Sand Arb 3268

Gas _____

Oil _____

Total Depth 3286

PRODUCTION

1st 24 hrs. Nat. _____

1st 24 hrs. after shot _____

Gas _____ Cu. Ft.

Dry Hole _____

Abandoned _____

Date

MAR 8 - 1939 19

H. D. Hatfield Scout