


Section 5 Township 18 Range 14-W

Well No. #1 Prose

Company G-N-R Oil

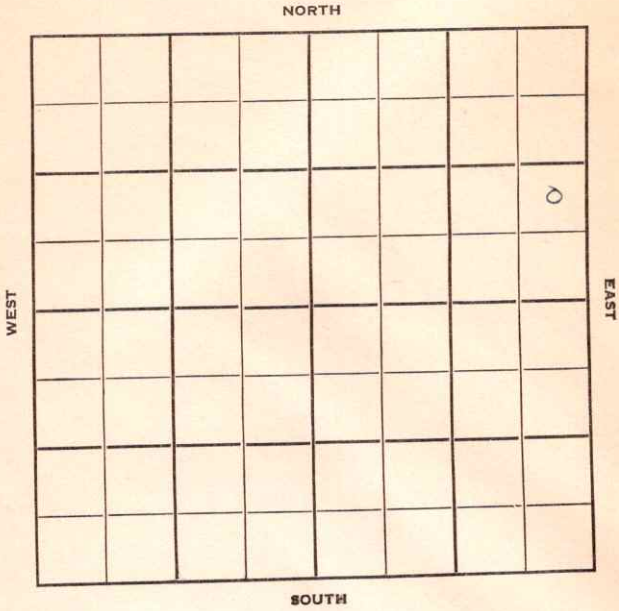

Barton **KANSAS**

Sec. 5 Twp. 18 R. 14W

Well No. #1 Prose Farm

G-M-R Oil Company


G-M-R Contractor
Boyd Pool

 Ft. from N. Line

990' Ft. from S. Line

330' Ft. from E. Line

 Ft. from W. Line

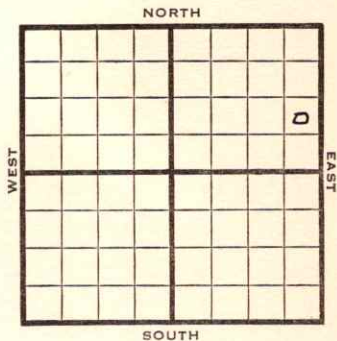

NE SE NE

1950 **Elev 1988** REPORT

8/9 Location

10/4 Spud 8-14-50
8 5/8" @ 232

Lans 3234

Arb 3469

SO 3474-77

5" @ 3471

TD 3478

FU 1000' oil 4 hr

P/210 bo 48 hr

Comp 266 bopd

Completed

COMPLETED

County Barton State Kansas

Sec. 5 (Blk.) 18 (Sur.) 14W Map No.

Operator G-M-R Oil

Well No. 1 Farm Prose

Elev. 1988 Location NE SE NE

					0

990 Ft. From S Line NE

330 Ft. From E Line Quarter

1st. Report

OCT 4 1950

Completion

Remarks Boyd Pool

G-M-R - Contr.

Spudding Date 8-14-50

Drlg. Data Oil well TD 3478

8 5/8" @ 232 Lens. 3234 Arb. 3469

SO 3474-77 5" @ 3471 TD 3478

FU 1000' oil 4 hr. P/ 210 bo 48 hr.

Comp. 266 bopd

J. E. TYRA