


Butler

SECTION 18 TOWNSHIP 26 RANGE 3E

WELL NO. #1 G. Edson

COMPANY Bedell & Catt

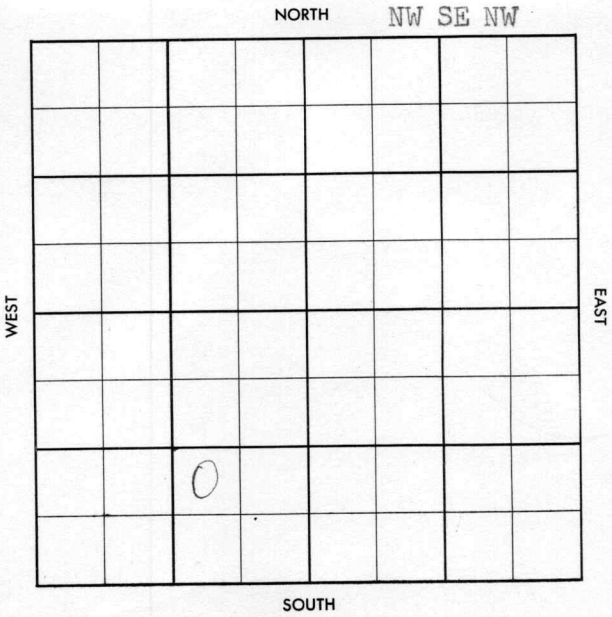

Please give us the well number.

FORM 513 SUNRAY

County Butler Elev. 1390 DF Co. Co.  
 Sec. 18 Twp. 26 Rge. 3E  
 Company Bedell & Catt  
 Farm Name G. Edson No. 1

TOPS	DEPTH	LOG	DATUM	Loc. in Sec.									
Anh.				NW SE NW									
TP.													
H.													
Tr.													
Dg.													
BL.													
L.				Geol.									
K.C.				Contr.									
B.K.C.				Co. Tools									
Ce.				Pool									
C.				Greenwich									
M.				<table border="1"> <tr> <td></td> <td></td> <td></td> </tr> <tr> <td></td> <td>o</td> <td></td> </tr> <tr> <td></td> <td>MAY 29 '57</td> <td></td> </tr> </table>					o			MAY 29 '57	
	o												
	MAY 29 '57												
K.													
Mz.													
Mq.													
V.													
S.													
S.													
A.													
R.													
PE.													
G.													
T.D.				FIRST REPORT									

Date Comm. 5-24-57  
8" @ 140, Drlg. 1343

29

Co.  
Lse.  
No.  
Sec.  
T.  
R.

Please give us the well number.


Thanks.

Co. 1390 DE  
 County Butler  
 Rgs. 3E  
 Company Bedell & Catt  
 Farm Name G. Edson  
 No. 1

TOPS	DEPTH	LOG	DATUM
And.			
Top.			
H.			
T.			
D.			
B.			
L.			
K.C.			
B.K.C.			
C.			
C.			
M.			
M.			
K.			
M.			
M.			
V.			
S.			
S.			
A.			
R.			
P.			
G.			
R.			

Loc. in Sec. NW SE NW  
 Geol.  
 Cont. Co. Tools  
 Pool Greenwich  
 No. 1  
 FIRST REPORT  

 8" @ 140' Drlg. 1343  
 T.  
 R.


Co.

County Butler Elev. 1390 DF  
 Sec. 18 Twp. 26 Rge. 3E  
 Company Bedell & Catt  
 Farm Name G. Edison No. 1

TOPS	DEPTH	LOG	DATUM
Anh.			
Tr.			
H.			
Tr.			
Dg.			
Bl.			
L.	<u>2414</u>		
K.C.			
B.K.C.	<u>2564</u>		
Ce.			
C.			
M.	<u>2859</u>		
M. <u>chert</u>	<u>2884</u>		
K. <u>M.LI</u>	<u>2934</u>		
Mz.			
Me.			
V.			
S.			
S.			
A.			
R.			
PE.			
G.			
T.D.	<u>2936</u>		

Loc. in Sec. NW SE NW  
 Geol. \_\_\_\_\_  
 Contr. \_\_\_\_\_  
 Co. Tools \_\_\_\_\_  
 Pool \_\_\_\_\_  
 Greenwich

Use

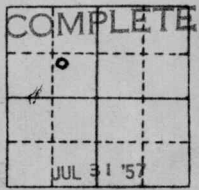

No.

Date Comm. 5-24-57  
8" @ 140; Drlg. 1343 JUN 5 '57 OST  
2875-90 1hr 269' oil + 180'  
0 8' 6 CM + 155' 50 8' 6 CM + 155'  
SW FP 30-300 BHP 685/20  
5 1/2 2935 JUN 12 '57 ~~WOST~~ JUN 19 '57 ✓  
JUN 26 '57 ~~WOST~~ JUL 3 '57 JUL 10 '57 MICT  
JUL 17 '57 JUL 24 '57 JUL 31 '57 CO 8/2884-86  
P. 25 Bopd + 50% wtr

Sec.

T.

R.