


Section 5 Township 18 Range 11W

Well No. #5 Prose

Company Messman & Rinehart

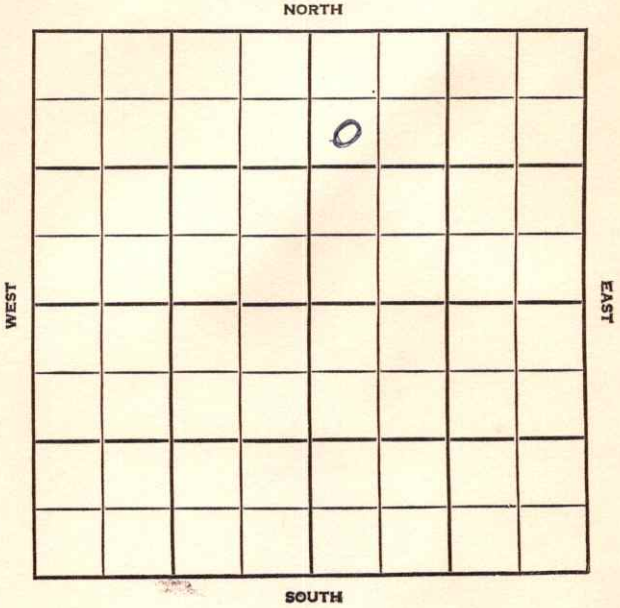

County	Barton	Elev.	1945	Co.
Sec.	5	Twp.	18	Rge.
			14W	
Company	Messman & Rinehart			
Farm Name	Prose	No.	5	

TOPS	DEPTH	LOG	DATUM	Loc. in Sec.
Anh.	945			SW NW NE
Tr.				
Dg.				
Bl.				
L.				Geol.
K.C.				Contr.
B.K.C.				Hulm Tools
Ce.				Pool
C.				Boyd
M.				
M.				
K.				
Mz.				
Mq.				
V.				
S.				
S.				
A.				
R.				
Pe.				
G.				
T.D.				

NOV 21 1956

FIRST REPORT

Date Comm. spd. 11-12-56
8" @ 640 w/225, Drlg. 3089

~~13~~

County Barton Elev. 1945
 Sec. 5 Twp. 18 Rge. 14W
 Company Messman & Rinehart
 Farm Name Prose No. 5

TOPS	DEPTH	LOG	DATUM	Loc. in Sec.
Anh.	745			SW NW NE
TP.				
H.	3124			
Tr.				
Dg.				
BL.				
L.	3187			Geol.
K.C.				Contr.
B.K.C.				Hulm Tools
Ce.				Pool
C.				Boyd
M.				
M.				
K.				
Mz.				
Me.				
V.				
S.				
S.				
A.				
R.				
Pe.				
G.				
TD.	3205			

NOV 29 1956
 ABANDONE

Date Comm. spd. 11-12-56
8" @ 640 w/225, Drlg. 3089 NOV 28 '56

D&A