


Section 21 Township 31 Range 4-E

Well No. #9 Hittle (Twin Well #4)

Company Texas

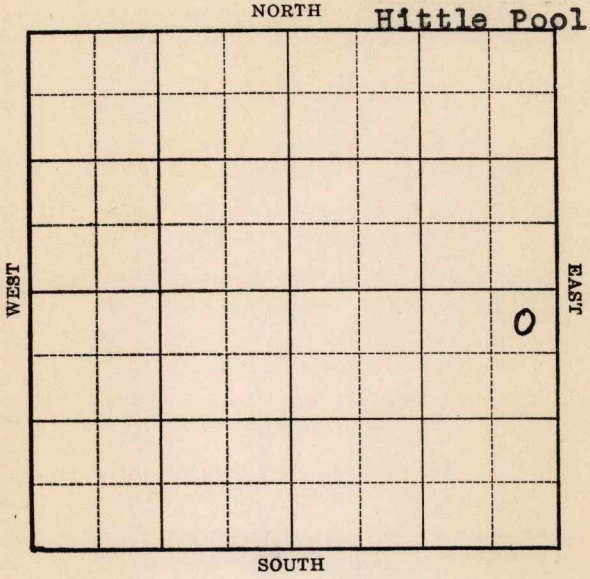



Map No. 2 Sec. 21 Twp. 31 R. 4E

Well No. 9 Hittle (Twin Well #4)

Texas

Company \_\_\_\_\_

Contractor \_\_\_\_\_

### FIRST REPORT

**NE SE**

320 Ft. from N. Line

\_\_\_\_\_ Ft. from S. Line

350 Ft. from E. Line

\_\_\_\_\_ Ft. from W. Line

### SECTION PLAT

			0

### HITTLE POOL

Location \_\_\_\_\_

Rig up \_\_\_\_\_

Drilling and Remarks:

**Rotary**

### RECORD

Cased \_\_\_\_\_ in., \_\_\_\_\_ ft.

Sand \_\_\_\_\_

Gas \_\_\_\_\_

Oil \_\_\_\_\_

Total Depth \_\_\_\_\_

### PRODUCTION

1st 24 hrs. Nat. \_\_\_\_\_

1st 24 hrs. after shot \_\_\_\_\_

Gas \_\_\_\_\_ Cu. Ft.

Dry Hole \_\_\_\_\_

Abandoned \_\_\_\_\_

Date

**JUL 5 1939**

19

**S. J. LEWIS**

Scout

Map No. 2 Sec. 21 Twp. 31 R. 4E

Well No. 9 Hittle (Twin #4)

Texas

Company \_\_\_\_\_

Contractor \_\_\_\_\_

COMPLETED  
NE SE

SECTION PLAT

			0

320 Ft. from N. Line

\_\_\_\_\_ Ft. from S. Line

350 Ft. from E. Line

\_\_\_\_\_ Ft. from W. Line

HITTLE POOL

Location \_\_\_\_\_

RECORD

Cased \_\_\_\_\_ in., \_\_\_\_\_ ft.

Sand \_\_\_\_\_

Gas \_\_\_\_\_

Oil \_\_\_\_\_

Total Depth 3334

PRODUCTION

1st 24 hrs. Nat. \_\_\_\_\_

1st 24 hrs. after shot \_\_\_\_\_

Gas \_\_\_\_\_ Cu. Ft.

Dry Hole \_\_\_\_\_

Abandoned \_\_\_\_\_

Rig up \_\_\_\_\_

Drilling and Remarks:

*Oil & 3323*

*7" C 3323*

*Pump & low.*

*2171 P & Y.*

Date

AUG 2 1939

19

S. J. LEWIS

Scout