


Section 8 Township 18 Range 14W

Well No. 2 Rowley

Company Harbar

Boyd Pool
NORTH

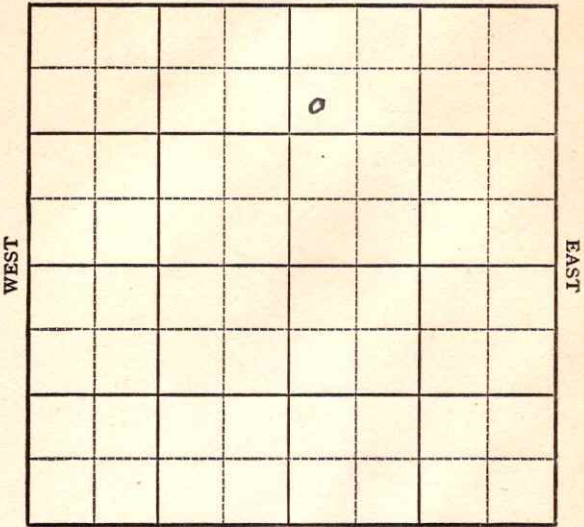

SOUTH

KANSAS

Barton

Sec. 8 Twp. 18 R. 14W

Well No. #2 Rowely Farm

Harbar

Company

Boyd Pool


990' Ft. from N. Line

_____ Ft. from S. Line

_____ Ft. from E. Line

330' Ft. from W. Line

SW NW NE

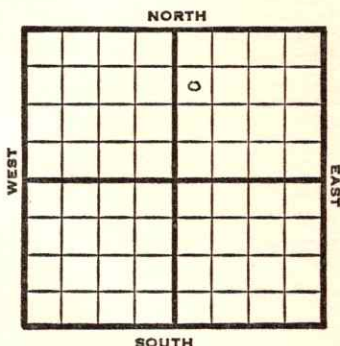

1948

Elev. 1982' REPORT

12/29 8" @ 960'

1/5 Drlg/ 2800'

1/12 **Lansing 3228 Arbuckle 3471-75 TD**

5" @ 3471

1/19 1000 acid

Swb 24 bbls oil PH 2 hrs.

1/26 "

2/2 "

2/9 "

2/16 **Arb. 3471'**

5" @ 3471'

1000 acid

Pump 420 oil Pot.

Gr. 38°

TD 3475'

COMPLETED

Map No. _____ Sec. 8 Twp. 18 R. 14W

Well No. 2 Rowley

Harbar


Company

FIRST REPORT

Contractor

SW NW NE

SECTION PLAT

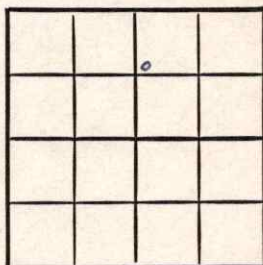

990 Ft. from N. Line

_____ Ft. from S. Line

_____ Ft. from E. Line

330 Ft. from W. Line

Barton County

Location _____

Rig up _____

Drilling and Remarks:

8" @ 960

RECORD

Cased _____ in., _____ ft.

Sand _____

Gas _____

Oil _____

Total Depth _____

PRODUCTION

1st 24 hrs. Nat. _____

1st 24 hrs. after shot _____

Gas _____ Cu. Ft.

Dry Hole _____

Abandoned _____

Date

DEC 29 1948 19 S. J. LEWIS Scout

Map No. K73 Sec. 8 Twp. 18 R. 14W

Well No. 2 Rowley

Harbar Company

COMPLETE

Contractor

SW NW NE

21, 1952
SECTION PLAT

990 Ft. from N. Line

 Ft. from S. Line

 Ft. from E. Line

330 Ft. from W. Line

		8	

Barton County

Location

Rig up

Drilling and Remarks:

*Per 83471
5' 203471
1000000
Pump 420 oil Rod
85-4*

RECORD

Cased in., ft.

Sand

Gas

Oil

Total Depth 3421-

PRODUCTION

1st 24 hrs. Nat.

1st 24 hrs. after shot

Gas Cu. Ft.

Dry Hole

Abandoned

Date

FEB 16 1949 19

S. J. LEWIS

Scout