

Barton

KANSAS

Sec. 9 Twp. 18 R. 14W

Well No. #2 Keener Farm _____

Lewis Drlg. Company _____

Contractor _____


990' Ft. from N. Line

_____ Ft. from S. Line

_____ Ft. from E. Line

990' Ft. from W. Line

SE NW SE

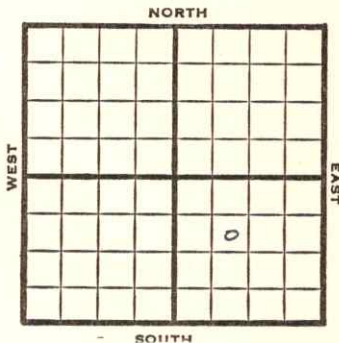

1950

Elev. 1953'

REPORT

12/20

Spud 12-18-50
8" @ 158'

1951

3/28

Spud 12-18-50
Oil Well TD 3455
8" @ 158'
Anhy 910' **Heeb. 3121**
Dodge 3132' **KC 3191**
DST 3194-3209 opn 45 min.
Rec. 210' oil
Arb. 3450 TD 3455
5" @ 3450 600 A
S/water SP 69/3199-3222
92/3199-3222 5000 A
3 boph P/25 bopd
Comp. 41 bopd

COMPLETED

County Barton State Kansas

Sec. 9 (Blk. Twp.) 18 (Sur. Rge.) 14W Map No.

Operator Lewis Drlg.

Well No. 2 Farm Keener

Elev. _____ Location SE NW SE

FIRST REPORT

990 Ft. From N Line SE

990 Ft. From W Line Quarter

lst. Report DEC 20 1950

Completion _____

Remarks _____

Spudding Date 12-18-50

Drlg. Data _____

8" @ 158

J. E. TYRA

County Barton State Kansas
 Sec. 9 (Blk. 18 (Sur. 14W Map No.)
 (Twp.) (Rge.)
 Operator Lewis Drlg.
 Well No. 2 Farm Keener
 Elev. 1953 Location SE NW SE



990 Ft. From N Line SE
990 Ft. From W Line Quarter

Ist. Report

Completion MAR 28 1951

Remarks

Spudding Date 12-18-50

Drlg. Data Oil well TD 3455
8" @ 158 Anhy 910 Heeb. 3121
Dodge 3132 KC 3191 DST 3194-3209
open 45 min. Rec. 210' oil Arb. 3450
TD 3455 5" @ 3450 600 A S/ water
SP 69/ 3199-3222 92/ 3199-3222
5000 A 3 boph P/ 25 bopd
Comp. 41 bopd

J. E. TYRA