

# KANSAS


Cowley

Form 51-5M-7-39-Palace

Section 21 Township 31 Range 4-E

Well No. #6 Hittle

Company Hawkeye Oil

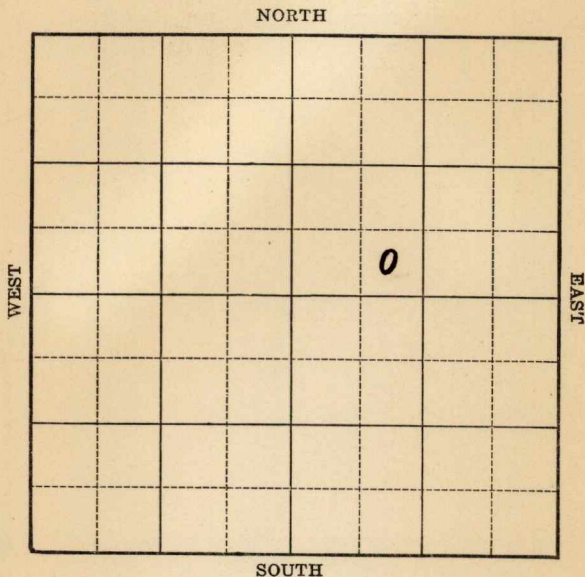

Sec. 21 Twp. 31 R. 4-E

Well No. #6 Hittle Farm

Hawkeye Oil Company


(Hittle)

\_\_\_\_\_ Ft. from N. Line

330 Ft. from S. Line

\_\_\_\_\_ Ft. from E. Line

990 Ft. from W. Line

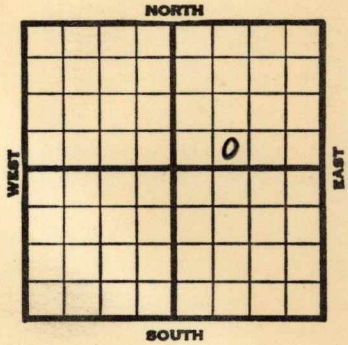

1940	REPORT
1/17	Location
2/1	10" - 64' T.D. 80' WOC.
2/8	Drlg. 2190'
2/15	Miss. 2982' B. Miss. 3222'
	Drlg. 3265'
2/23	7" - 3265' C.O.
2/29	Arb. 3286' T.D. 3297½'
	Flow 100 bbls. per hour.
3/8	Tubing.
3/13	Arb. 3286'
	7" - 3265'
	T.D. 3297½'
	Potential 3798 bbls. on pump.
	Maximum 3000 bbls.
	<b>COMPLETED</b>

Map No. 2 Sec. 21 Twp. 31 R. 4E

Well No. 6 Hittle

Hawkeye Oil Company

Contractor

FIRST REPORT

SECTION PLAT

SE SW NE

\_\_\_\_\_ Ft. from N. Line

330 Ft. from S. Line

\_\_\_\_\_ Ft. from E. Line

990 Ft. from W. Line


HITTLE POOL

Location X

Rig up \_\_\_\_\_

Drilling and Remarks:

RECORD

Cased \_\_\_\_\_ in., \_\_\_\_\_ ft.

Sand \_\_\_\_\_

Gas \_\_\_\_\_

Oil \_\_\_\_\_

Total Depth \_\_\_\_\_

PRODUCTION

1st 24 hrs. Nat. \_\_\_\_\_

1st 24 hrs. after shot \_\_\_\_\_

Gas \_\_\_\_\_ Cu. Ft.

Dry Hole \_\_\_\_\_

Abandoned \_\_\_\_\_

Date

JAN 17 1940 19

S. J. LEWIS Scout

5m - Our Maps show 4#2  
Completed here - *Pitman*

Well No. 6 Hittle

Hawkeye Oil

SECTION PLAT


SE SW 1/4

ft. from N. Line

330 ft. from S. Line

ft. from E. Line

990 ft. from W. Line

HITTLE POOL

RECORD

Location

Cased

Ris. up

Drilling and Remarks

- Misc Small Maps
- Cards
- Tracing
- France Map
- Scarborough Map
- Moody Map
- Geological Dept.
- Moody Plat Book

Date

Cowley

Map No. \_\_\_\_\_ Sec. 21 Twp. 31 R. 4E

Well No. 6 Hittle (This lease was  
Hawkeye Oil (Trees Oil, then  
 \_\_\_\_\_ Company  
 (McKnab & Blair))

**CORRECTION**

Contractor

**SECTION PLAT**

**SE SW NE**


\_\_\_\_\_ Ft. from N. Line

330 Ft. from S. Line

\_\_\_\_\_ Ft. from E. Line

990 Ft. from W. Line

**HITTLE POOL**

Location X

Rig up \_\_\_\_\_

Drilling and Remarks:

This is twin to  
 old #4 Trees Oil Co.  
 and has been abd.

**RECORD**

Cased \_\_\_\_\_ in., \_\_\_\_\_ ft.

Sand \_\_\_\_\_

Gas \_\_\_\_\_

Oil \_\_\_\_\_

Total Depth \_\_\_\_\_

**PRODUCTION**

1st 24 hrs. Nat. \_\_\_\_\_

1st 24 hrs. after shot \_\_\_\_\_

Gas \_\_\_\_\_ Cu. Ft.

Dry Hole \_\_\_\_\_

Abandoned \_\_\_\_\_

Date

JAN 24 1940 19

S. J. LEWIS

Scout

Map No. 2 Sec. 21 Twp. 31 R. 4E

Well No. 6 Hittle (twin to #4 drilled  
Hawkeye Oil by Trees Ahd.)  
Company

Contractor

**COMPLETED**

**SECTION PLAT**

**SE SW NE**

\_\_\_\_\_ Ft. from N. Line

330 Ft. from S. Line

\_\_\_\_\_ Ft. from E. Line

990 Ft. from W. Line

**HITTLE POOL**


Location \_\_\_\_\_

Rig up \_\_\_\_\_

Drilling and Remarks:

*CR # 3256*

*7" @ 3265.*

*Pump 3798 AD*

*Maximum 3500*

**RECORD**

Cased \_\_\_\_\_ in., \_\_\_\_\_ ft.

Sand \_\_\_\_\_

Gas \_\_\_\_\_

Oil \_\_\_\_\_

Total Depth 3297 1/2

**PRODUCTION**

1st 24 hrs. Nat. \_\_\_\_\_

1st 24 hrs. after shot \_\_\_\_\_

Gas \_\_\_\_\_ Cu. Ft.

Dry Hole \_\_\_\_\_

Abandoned \_\_\_\_\_

Date

MAR 13 1940

19

S. J. LEWIS

Scout