


Section 9 Township 18 Range 14W

Well No. 3 Logan

Company Gulf
Boyd

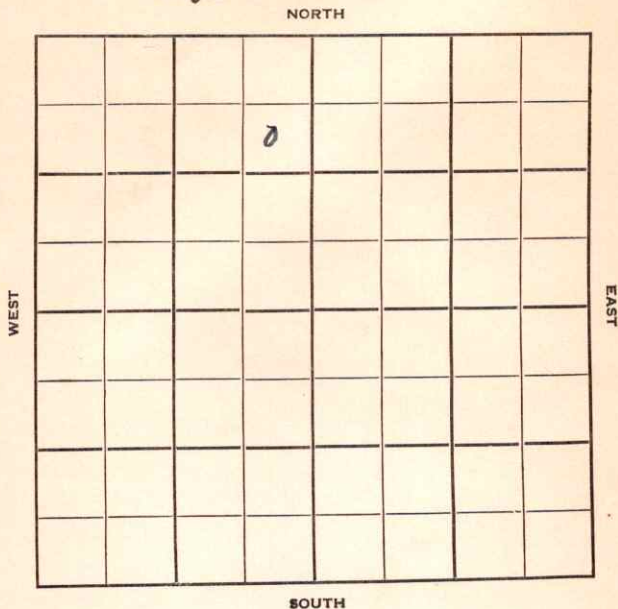

Sec. 9 Twp. 18 R. 14W ✓

Well No. #3 Logan Farm

Gulf

Boyd Pool (Torbett & Barber, Cont.) Company


990' Ft. from N. Line

 Ft. from S. Line

330' Ft. from E. Line

 Ft. from W. Line

SE NE NW

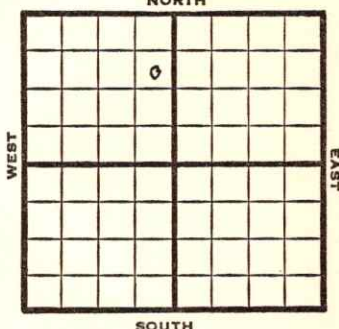

1949

Elev 1955'

R E P O R T

6/15

10" @ 146'
Drlg. 240'

6/21

8"@ 938'
Drlg 3320'

6/28

Abuckle 3446-
5"@ 3447'
TD 3447'

7/6

"

7/12

TD 3449
500 acid
Swb 109 bbls oil 9 hrs.

7/20

"

7/27

"

8/3

"

8/10

TD 3449'
Arb. 3446'
5"@ 3447'
500 acid
Pump 210 oil / 4% W Pot
36° Gr.
Comp

COMPLETED

Barton County Kansas State

Map No. _____ Sec. 9 Twp. 18 R. 14W

Well No. 3 Logan

Gulf Company

Torbett & Barber Contractor

SE NE NW

FIRST REPORT SECTION PLAT

990 Ft. from N. Line

_____ Ft. from S. Line


330 Ft. from E. Line

_____ Ft. from W. Line

Boyd Pool

Remarks:

10" @ 146 drlg. 240

 

Date

JUN 15 1949

Scout

S. J. LEWIS

Map No. K23 Sec. 9 Twp. 18 R. 14W

Well No. 3 Logan

Gulf

Company

COMPLETE

Contractor

SE NE NW

E 1955
SECTION PLAT

990 Ft. from N. Line

Ft. from S. Line

330 Ft. from E. Line

Ft. from W. Line

	6		

Barton County

RECORD

Location

Cased _____ in., _____ ft.

Rig up

Sand _____

Drilling and Remarks:

Gas _____

Oil _____

Total Depth 3449

PRODUCTION

1st 24 hrs. Nat. _____

1st 24 hrs. after shot _____

Gas _____ Cu. Ft.

Dry Hole _____

Abandoned _____

Date

AUG 10 1949 19 S. J. LEWIS Scout