


Section 9 Township 18 Range 14W

Well No. 4 Logan

Company Republic Nat. Gas

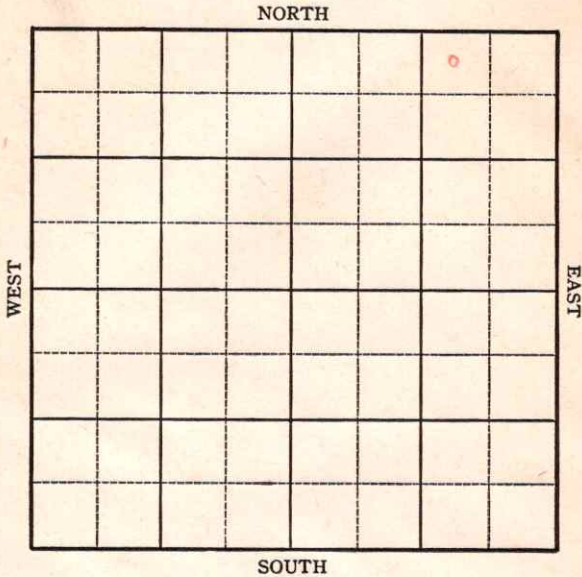

Sec. 9 Twp. 18 R. 14-W

Well No. #4 Logan Farm


Republic Nat. Gas Company

330 Ft. from N. Line

\_\_\_\_\_ Ft. from S. Line

990 Ft. from E. Line

\_\_\_\_\_ Ft. from W. Line

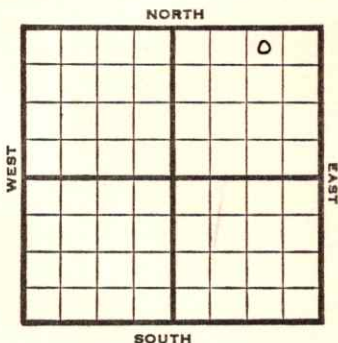

NW NE NE

**1945 Elev. 1933' REPORT**

11/14 RUR  
 11/21 **Anhy . 877**  
 10" @ 899' WOC  
 11/28 Drlg. 3015'  
 12/5 **Anhy. 881**  
**Lans 3164**  
**Arb. 3415-3416**  
 TD 3416  
 7" @ 3415 RUST  
 12/12 PB 3380  
 10 shots 3323-3328 no shows  
 12/20 500 acid. 9 shots 3230-38'  
 500 acid. Swab 4 bbls fluid per  
 hour. 4% water.  
 12/29 " " "  
 1946 " " "  
 1/10 " " "  
 1/17 Squeeze.  
 1/24 T.D. 3419'  
 1/31 " "  
 2/7 " "  
 2/14 " "  
 2/21 " "  
 2/27 **Arb. 3415**  
 7" @ 3415  
 TD 3419  
 Pump 190 Pot.  
 Grav. 36.0

**COMPLETED**



Kansas Pool Name BoydMap No. 23 Sec. 9 Twp. 18 R. 14WWell No. 4 Logan

Republic Nat. Gas

Company

COMPLETED

Contractor

NW NE NE

E 11933  
SECTION PLAT330 Ft. from N. Line

\_\_\_\_\_ Ft. from S. Line

990 Ft. from E. Line

\_\_\_\_\_ Ft. from W. Line

			0

Barton County

Location \_\_\_\_\_

Rig up \_\_\_\_\_

Drilling and Remarks:

*CR 43415**7" 03415**Pump 19088**36° SW*

## RECORD

Cased \_\_\_\_\_ in., \_\_\_\_\_ ft.

Sand \_\_\_\_\_

Gas \_\_\_\_\_

Oil \_\_\_\_\_

Total Depth 3419

## PRODUCTION

1st 24 hrs. Nat. \_\_\_\_\_

1st 24 hrs. after shot \_\_\_\_\_

Gas \_\_\_\_\_ Cu. Ft.

Dry Hole \_\_\_\_\_

Abandoned \_\_\_\_\_

Date

FEB 27 1946 19

S. J. LEWIS

Scout