


Barton

FORM 51 IOM 12-46 PETROL **KANSAS**

Section 9 Township 18 Range 14W

Well No. 5 Logan

Company Republic Natural Gas

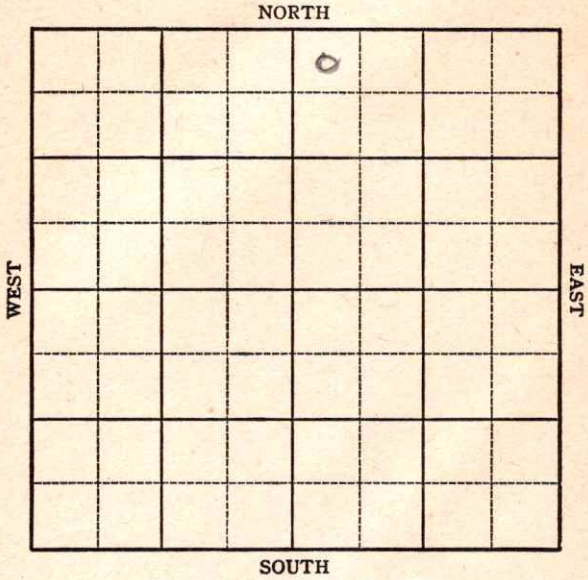

KANSAS

Barton county ✓

Sec. 9 Twp. 18 R. 14W

Well No. 5 Logan Farm _____
Republic Natural Gas Company _____


Boyd Pool

330 Ft. from N. Line

_____ Ft. from S. Line

_____ Ft. from E. Line

330 Ft. from W. Line

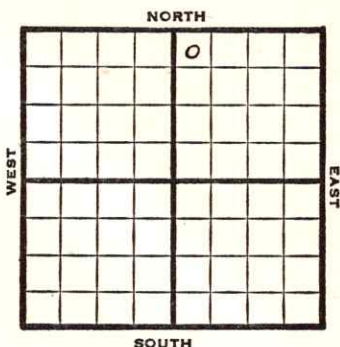

NW 9 NE

1947 **Elev. 1970'** REPORT

5/28	Drlg. 430'
6/3	10" @ 931 Drlg 2010'
6/10	10" Drlg. 3346'
6/17	Arbuckle 3441-43 TD 7" @ 3442 RUST
6/24	"
7/1	TD 3448' 1700' oil 24 hrs.
7/8	" "
7/16	" "
7/22	" "

OVER

Map No. _____ Sec. 9 Twp. 18 R. 14W

Well No. 5 Logan

Republic Natural Gas Company

FIRST REPORT

Contractor

NW NE

SECTION PLAT

330 Ft. from N. Line

_____ Ft. from S. Line

_____ Ft. from E. Line

330 Ft. from W. Line

		0	

Barton County

Location _____

Rig up _____

Drilling and Remarks:

drlg. 430

RECORD

Cased _____ in., _____ ft.

Sand _____

Gas _____

Oil _____

Total Depth _____

PRODUCTION

1st 24 hrs. Nat. _____

1st 24 hrs. after shot _____

Gas _____ Cu. Ft.

Dry Hole _____

Abandoned _____

Date

MAY 28 1947 19

S. J. LEWIS Scout

Kansas

Map No. 73 Sec. 9 Twp. 18 R. 14WWell No. 5 LoganRepublic Natural Gas CompanyCOMPLETE Contractor

NW NE

E 11970
SECTION PLAT330 Ft. from N. Line Ft. from S. Line Ft. from E. Line330 Ft. from W. Line

		0	

Barton County

Location _____

Rig up _____

Drilling and Remarks:

Cr 344174 @ 3442Depth 8000.860/4

RECORD

Cased _____ in., _____ ft.

Sand _____

Gas _____

Oil _____

Total Depth 3442

PRODUCTION

1st 24 hrs. Nat. _____

1st 24 hrs. after shot _____

Gas _____ Cu. Ft.

Dry Hole _____

Abandoned _____

Date

JUL 30 1947 19S. J. LEWIS Scout

1947

7/30

Arb. 3441'

7" @ 3442'

Depth Pot

3000

Gr. 36.0

TD 3448'

COMPLETED