

KANSAS

FORM 51 IOM 12-46 PETROL


Barton

Section 9 Township 18 Range 14-W

Well No. 2 Logan

Company Gulf

Boyd Pool

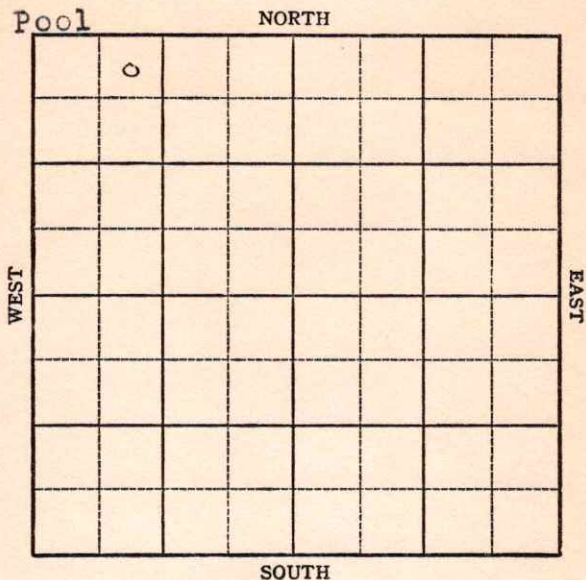

KANSAS

Barton

Sec. 9 Twp. 18 R. 14W

Well No. #2 Logan Farm _____

Gulf Company

Boyd


330 Ft. from N. Line

_____ Ft. from S. Line

_____ Ft. from E. Line

990 Ft. from W. Line

NE NW NW

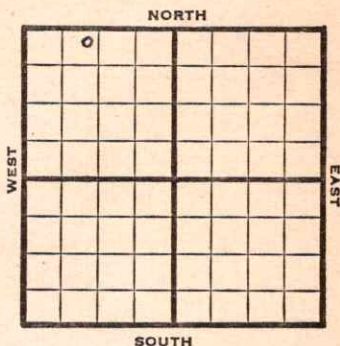

1947

Elev. 1985' REPORT

- 10/8 Location
- 10/15 13" @ 301'
Drlg. 400'
- 10/22 8" @ 948'
Drlg. 2435'
- 10/29 ~~Arbuckle 3475'~~
Drlg. 3480'
- 11/5 **Lansing 3218'**
TD 3480'
5" @ 3477'
RUST
- 11/12 **Arbuckle 3478' Corrected**
5" @ 3489'
TD 3490'
PB 3487' - 500 acid.
- 11/19 Pump 29 bbls oil & 34 W PH - 17 hrs.
- 11/25 "
- 12/3 **Arbuckle 3478'**
5" @ 3480'
Acid 500
Pump 31 oil & 60% W Pot
Gr. 36°
Total Depth 3490'

COMPLETED

Map No. _____ Sec. 9 Twp. 18 R. 14W

Well No. 2 Logan

Gulf Company

FIRST REPORT Contractor

NE NW NW

SECTION PLAT

330 Ft. from N. Line

_____ Ft. from S. Line

_____ Ft. from E. Line

990 Ft. from W. Line

0			

Barton County

Location X

Rig up _____

Drilling and Remarks:

RECORD

Cased _____ in., _____ ft.

Sand _____

Gas _____

Oil _____

Total Depth _____

PRODUCTION

1st 24 hrs. Nat. _____

1st 24 hrs. after shot _____

Gas _____ Cu. Ft.

Dry Hole _____

Abandoned _____

Date

OCT 8 1947 19

S. J. LEWIS Scout

Boyd Pool

Form 26 200 Bks. 10-46 Petrol
Kansas

Map No. 73 Sec. 9 Twp. 18 R. 14W

Well No. 2 Logan

Gulf Company

COMPLETE Contractor

NE NW NW

E41985

SECTION PLAT

0			

330 Ft. from N. Line

_____ Ft. from S. Line

_____ Ft. from E. Line

990 Ft. from W. Line

Barton County

Location _____

Rig up _____

Drilling and Remarks:

*Per 3478
5 @ 3480
500 acid
Pump 31 oil +
60% W.P.Y*

36 9/16

RECORD

Cased _____ in., _____ ft.

Sand _____

Gas _____

Oil _____

Total Depth 3490

PRODUCTION

1st 24 hrs. Nat. _____

1st 24 hrs. after shot _____

Gas _____ Cu. Ft.

Dry Hole _____

Abandoned _____

Date

DEC 3 1947 19

S. J. LEWIS Scout