KANSAS Cowley

Form 51—5M—7-39—Palace

Section 21 Township 31 Range 4-E

Well No. #5 Hittle Est.

Company McKnab & Blair

Hittle Pool

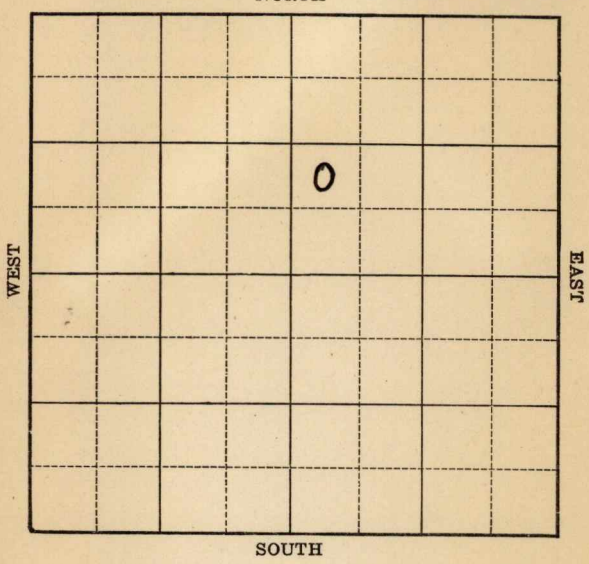

FORM 252-A 5M 4-39 KANSAS Cowley

Sec. 21 Twp. 31 R. 4-E

Well No. #5 Hittle Est. Farm

McKnab & Blair Company

(Hittle)

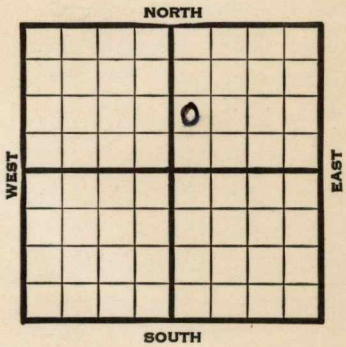

_____ Ft. from N. Line

990 Ft. from S. Line

_____ Ft. from E. Line

330 Ft. from W. Line

Elev. 1257

1939	REPORT
8/23	Rotary.
8/31	10" - 112' Drlg. 1445'
9/7	K. C. 2383' Miss. 3008'
	Drlg. 3131'
9/14	B. Miss. 3373' 7" - 3373'
	Arb. 3340' T.D. 3355'
	Flow 220 oil per hour.
9/20	Arb. 3340'
	7" - 3333'
	T.D. 3355'
	Pump & flow 7086 bbls.
	Maximum 2500 bbls.
	COMPLETED

Form 26—1M Bks.—2-29 KANSAS Cowley.

Map No. 2 Sec. 21 Twp. 31 R. 4E

Well No. 5 Hittle Est.

McKnat & Blair Company

Contractor

NW SW NE

FIRST REPORT

SECTION PLAT

		o	

_____ Ft. from N. Line

990 Ft. from S. Line

_____ Ft. from E. Line

330 Ft. from W. Line

Hittle Pool.

Location _____

Rig up _____

Drilling and Remarks:

Rotary

RECORD

Cased _____ in., _____ ft.

Sand _____

Gas _____

Oil _____

Total Depth _____

PRODUCTION

1st 24 hrs. Nat. _____

1st 24 hrs. after shot _____

Gas _____ Cu. Ft.

Dry Hole _____

Abandoned _____

Date

AUG 23 1939 19 _____ S. J. LEWIS Scout

Form 26—1M Bks.—2-29 Cowley KANSAS

Map No. 2 Sec. 21 Twp. 31 R. 4E

Well No. 5 Hittle est.

McKnab & Blair Company

Contractor

COMPLETED

NW SW NE

Ft. from N. Line

990 Ft. from S. Line

Ft. from E. Line

330 Ft. from W. Line

HITTLE POOL

SECTION PLAT

		o	

Location

Rig up

Drilling and Remarks:

Art 3340

7" C 3333

Pump & flow.

7 bbl 8 hr

Max. minus 2500

RECORD

Cased in., ft.

Sand

Gas

Oil

Total Depth 3356

PRODUCTION

1st 24 hrs. Nat.

1st 24 hrs. after shot

Gas Cu. Ft.

Dry Hole

Abandoned

Date

SEP 20 1939 19

S. J. LEWIS Scout