KANSAS

Form 51—5M—11-38—Palace

Cowley

Section 21 Township 31 Range 4-E

Well No. #4 Hittle (Twin #2)

Company McKnab & B. B. Blair

Hittle Pool

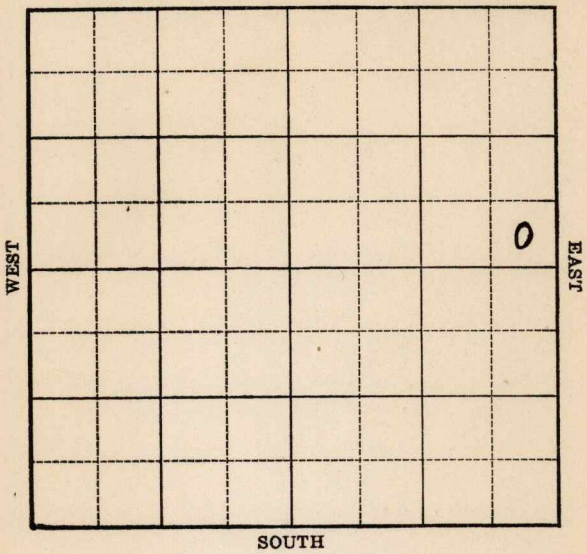

FORM 252-A 5M 4-39 KANSAS Cowley

Sec. 21 Twp. 31 R. 4-E

Well No. #4 Hittle (Twin #2) Farm

McKnab & B. B. Blair Company

(Hittle)

Ft. from N. Line

330 Ft. from S. Line

300 Ft. from E. Line

Ft. from W. Line

Elev. 1222

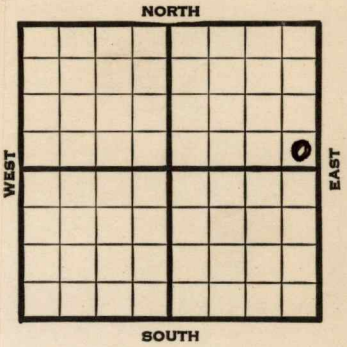

1939	REPORT
5/31	Rotary.
6/8	10" @ 109' Drlg. 2000'
6/16	Miss. 2946' Drlg. 3006'
6/23	Base Miss. 3176' 7" - 3241'
	Arb. 3269' Drlg. 3279' H.F.O.
6/29	T.D. 3299' Bottom hole pressure
	bomb test 388 bbls.
7/5	Miss. 2946'
	Arb. 3269'
	7" - 3241'
	T.D. 3299'
	Potential 2504 bbls., pump &
	flow.
	COMPLETED

Form 26—1M Bks.—2-29

Cowley KANSAS

Map No. _____ Sec. 21 Twp. 31 R. 4E

Well No. 4 Hittle (Twin #2)

McKnab & B.B.Blair Company

Contractor

FIRST REPORT

SE NE

_____ Ft. from N. Line

330 Ft. from S. Line

300 Ft. from E. Line

_____ Ft. from W. Line

HITTLE POOL

SECTION PLAT

			o

Location _____

Rig up _____

Drilling and Remarks:

ROTARY

RECORD

Cased _____ in., _____ ft.

Sand _____

Gas _____

Oil _____

Total Depth _____

PRODUCTION

1st 24 hrs. Nat. _____

1st 24 hrs. after shot _____

Gas _____ Cu. Ft.

Dry Hole _____

Abandoned _____

Date

MAY 31 1939 19

S. J. LEWIS Scout

Form 26—1M Bks.—2-29

Cowley

KANSAS

Map No. 2 Sec. 21 Twp. 31 R. 4E

Well No. 4 Hittle (Twin #2)

McKnab & B. B. Blair Company

Contractor

COMPLETED

SE NE

Ft. from N. Line

330 Ft. from S. Line

300 Ft. from E. Line

Ft. from W. Line

HITTLE POOL

SECTION PLAT

			o

Location

Rig up

Drilling and Remarks:

Miss 2946

Ar & 3269

7" @ 3241

Po & 2504 Pump & Flow.

RECORD

Cased in., ft.

Sand

Gas

Oil

Total Depth 3299

PRODUCTION

1st 24 hrs. Nat.

1st 24 hrs. after shot

Gas Cu. Ft.

Dry Hole

Abandoned

Date

JUL 5 1939 19

S. J. LEWIS Scout