

Barton

KANSAS

Section 10 Township 18 Range 14 W

Well No. # 6 Eveleigh

Company Lewis Drlg.

NORTH

				0			

WEST

EAST

SOUTH

Barton

KANSAS

Sec. 10 Twp. 18 R. 14W

Well No. #6 Eveleigh Farm

Lewis Drlg. Company

Lewis Drlg. - Contr. Contractor


330' Boyd Pool
Ft. from N. Line

_____ Ft. from S. Line

_____ Ft. from E. Line

330' Ft. from W. Line

NW NW NE

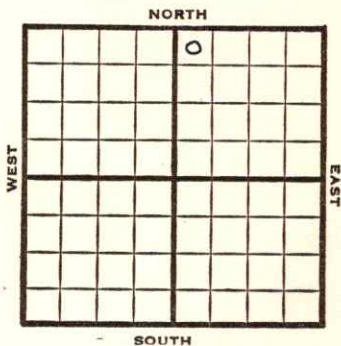

1951

Elev. 1893' REPORT

2/7

Spud 2-3-51
8" @ 610'
Anhy 840-65
Drlg. 1520'

5/29

Spud 2-3-51
Oil Well TD 3386
8" @ 610 **Anhy 840-65** Heeb. 3068
Lans. 3141 Cong. 3360 Arb. 3376
5" @ 3376-80 TD 3382 5 goph
250 A 20 goph 500 A 1/2 boph DD 3386
10 qt 1000 A wtr 23/3376-80
250 A Comp. 25 bopd

COMPLETED

County Barton State KansasSec. 10 (Blk.
Twp.) 18 (Sur.
Rge.) 14W Map No.Operator Lewis Drlg.Well No. 6 Farm EveleighElev. 1893 Location NW NW NE

			0		

330 Ft. From N Line NE330 Ft. From W Line Quarter1st. ReportCompletion MAY 29 1951Remarks Boyd PoolLewis Drlg. - Contr.Spudding Date 2-3-51Drlg. Data Oil well TD 33868" @ 610 Anhy 840-65 Heeb. 3068Lans. 3141 Cong. 3360 Arb. 33765" @ 3376-80 TD 3382 5 goph 250 A20 goph 500 A $\frac{1}{2}$ boph DD 338610 qt/ 1000 A water 23/ 3376-80250 A Comp. 25 boph

J. E. TYRA