


Section 23 Township 31 Range 4E

Well No. #1 Franks "A"

Company Anderson-Pritchard

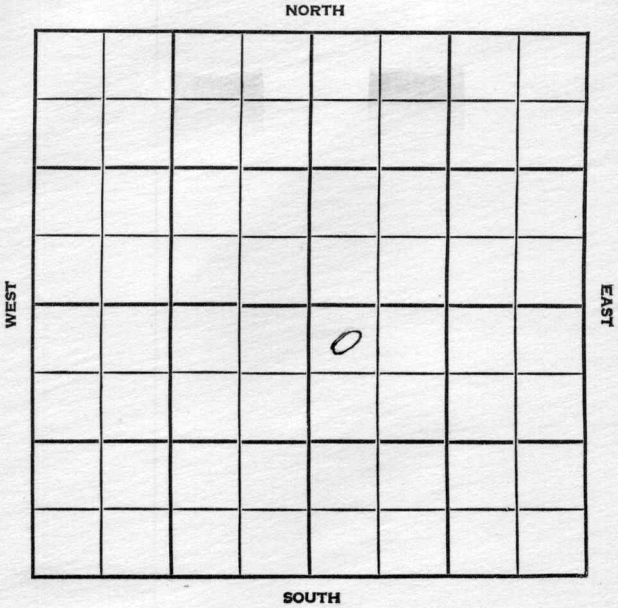

County Conley Elev. _____
 Sec. 23 Twp. 31 Rge. 4E
 Company Anderson-Pritchard
 Farm Name Franks "A" No. 1

TOPS	DEPTH	LOG	DATUM
Anh.			
Tp.			
H.			
Tr.			
Dg.			
Bl.			
L.			
K.C.			
B.K.C.			
Ce.			
C.			
M.			
M.			
K.			
Mz.			
Me.			
V.			
S.			
S.			
A.			
R.			
PE.			
G.			
T.D.			

Loc. in Sec. _____

NW NW SE

Geol. _____

Contr. _____

Peel Bros.

Tools
Pool

Diechman

FIRST REPORT

OCT 24 55

Date Comm. _____

Location _____

NOV 5 1955

R.G.

Co.

Loc.

No.

Sec.

T.

R.

Co.

County Cowley Elev. 1229
 Sec. 23 Twp. 31 Rge. 4E
 Company Anderson-Pritchard
 Farm Name Franks "A" No. 1

TOPS	DEPTH	LOG	DATUM	Loc. in Sec.
Anh.				NW NW SE
Tp.				Twin
H.				
Tr. <u>stall?</u>	<u>1905</u>			
Dg.				
Bl.				
L.				Geol.
N.C.				Cantr.
B.K.C.				Peel Bros.
Ce.				Tools
C.				Pool
M.				Diechman
M.				
K.				
Mz.				
Me.				
V.				
S.				
S.				
A.				
R.				
Pe.				
G.				
T.D.	<u>2031</u>			

Lse.

No.

Sec.

T.

R.



Date Comm.

Location OCT 31 '56 ✓ NOV 7 '56

water supply well NOV 13 '56

11-7-56 858 155-150

1959 NOV 21 '56 7" @ 2031/100

NOV 28 '56 complete for stall.

water supply well. (with PF. stall) 80/1905-25