

KANSAS


FORM 51 5M 1-42 PETROL

Cowley

Section 23 Township 31 Range 4-E
~~34~~

Well No. #5 Franks

Company Trees Oil

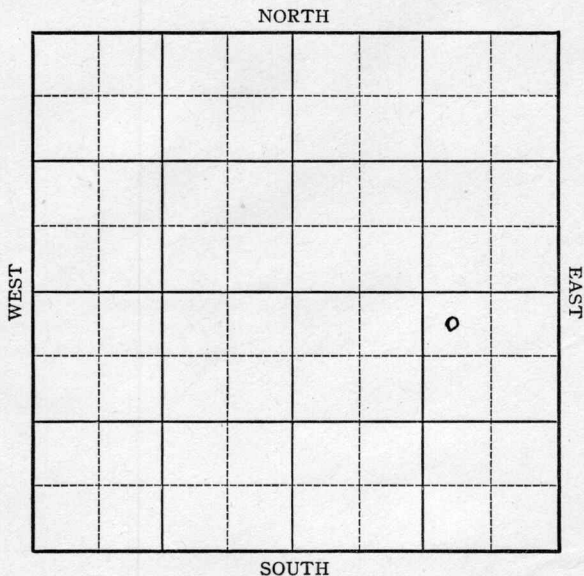

Sec. 23 Twp. 31 ~~34~~ R. 4-E

Well No. #5 Franks Farm
Trees Oil Company

Miscellaneous


330 Ft. from N. Line

_____ Ft. from S. Line

990 Ft. from E. Line

_____ Ft. from W. Line

Elev. 1215

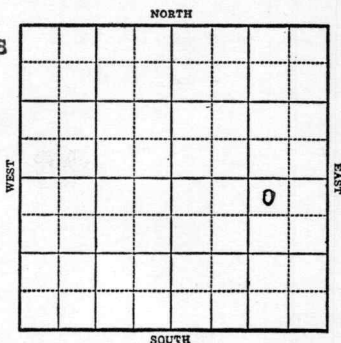

1943

R E P O R T

6/9	Location.
6/16	"
6/23	Cbale Rig
6/30	" "
7/7	15" @ 325' Drlg. 530'
7/15	12" @ 1210' Drlg. 1425'
7/21	Drlg. 2200'
7/28	2200 SD
8/4	" "
8/11	" "
8/18	10" @ 1690' KC 2323 Drlg. 2422'
8/25	Drlg. 2893'
9/1	5" @ 2870 T.D. 2923 WOC.
9/8	Chat 2935-37 T.D. 80 qts 2890-2930 flow 50 oil per hr

OVER

1943

9/15

Chat 2935

5" @ 2870

Bart 2868

Flow 994 Pot.

T.D. 2937

Gravity 36

COMPLETED

KANSAS

Map No. _____ Sec. 23 Twp. 34 R. 4E

Well No. 5 Franks

Trees Oil Company

FIRST REPORT Contractor

NW NE SE

SECTION PLAT

330 Ft. from N. Line

_____ Ft. from S. Line

990 Ft. from E. Line

_____ Ft. from W. Line

			o

MISCELLANEOUS

Location XXX

Rig up _____

Drilling and Remarks: _____

RECORD

Cased _____ in., _____ ft.

Sand _____

Gas _____

Oil _____

Total Depth _____

PRODUCTION

1st 24 hrs. Nat. _____

1st 24 hrs. after shot _____

Gas _____ Cu. Ft.

Dry Hole _____

Abandoned _____

Date

JUN 9 1943

19

S. J. LEWIS

Scout

KANSAS

Cowley

Map No. 2 Sec. 23 Twp. 31 R. 4E

Well No. 5 Franks

TREES oil

Company

CORRECTION

Contractor

NW NE SE

SECTION PLAT

330 Ft. from N. Line

_____ Ft. from S. Line

990 Ft. from E. Line

_____ Ft. from W. Line

			o

MISCELLANEOUS

Location _____

Rig up _____

Drilling and Remarks:

Reported

23-34-4E

RECORD

Cased _____ in., _____ ft.

Sand _____

Gas _____

Oil _____

Total Depth _____

PRODUCTION

1st 24 hrs. Nat. _____

1st 24 hrs. after shot _____

Gas _____ Cu. Ft.

Dry Hole _____

Abandoned _____

Date

JUN 1 6 1943 19____

S. J. LEWIS Scout

Cowley

KANSAS

Map No. 2 Sec. 23 Twp. 31 R. 4E

Well No. 5 Franks

Trees Oil Company

COMPLETED Contractor

NW NE SE

SECTION PLAT

330 Ft. from N. Line

_____ Ft. from S. Line

990 Ft. from E. Line

_____ Ft. from W. Line

			o

Miscellaneous

Location _____

Rig up _____

Drilling and Remarks:

Chat 2925
5" @ 2970
Bar 2965
Flow 994 Rod

36 1/2

RECORD

Cased _____ in., _____ ft.

Sand _____

Gas _____

Oil _____

Total Depth 2997

PRODUCTION

1st 24 hrs. Nat. _____

1st 24 hrs. after shot _____

Gas _____ Cu. Ft.

Dry Hole _____

Abandoned _____

Date

SEP 15 1943 19 _____

S. J. LEWIS

Scout