


Section 10 Township 18 Range 14-W

Well No. #1 Dietz

Company Harbar Drlg.

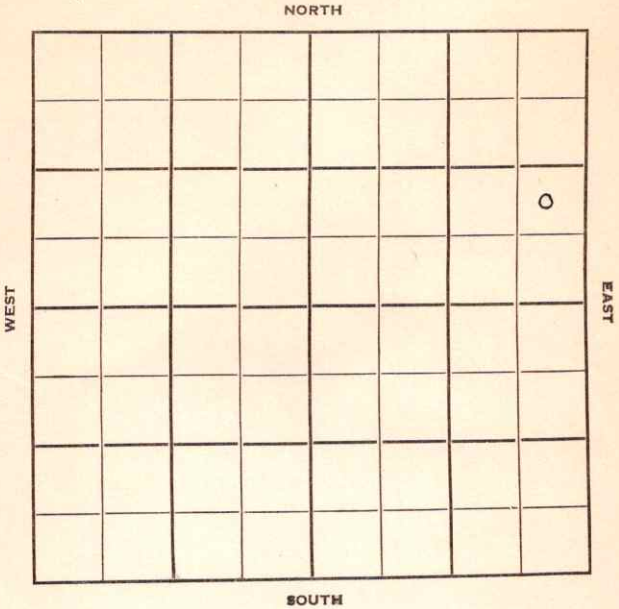

KANSAS

Barton

Sec. 10 Twp. 18 R. 14-W

Well No. #1 Dietz Farm

HarberDrlg. Company

Boyd

Contractor


Ft. from N. Line

990 Ft. from S. Line

330 Ft. from E. Line

Ft. from W. Line

NE SW NE

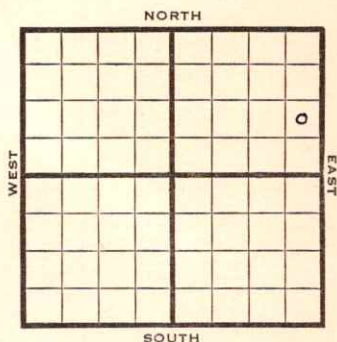

1950

Elev ?1924

REPORT

7/12 Spud 7-8-50
Drlg 870

8/30 13" @ 159

Anhy 880

Arb 3413-15

5" @ 3414

TD 3416

S/16 boph

Comp 454 bopd

Completed

COMPLETED

Kansas

Boyd Pool

Map No. _____ Sec. 10 Twp. 18 R. 14WWell No. 1 Dietz

_____ Harbar Drlg. _____ Company

_____ Contractor

NE SE NE

SECTION PLAT



_____ Ft. from N. Line

990 Ft. from S. Line330 Ft. from E. Line

_____ Ft. from W. Line

Barton County

Location _____

Rig up _____

Drilling and Remarks:

Spud 7-8-50

drlg. 870

RECORD

Cased _____ in., _____ ft.

Sand _____

Gas _____

Oil _____

Total Depth _____

PRODUCTION

1st 24 hrs. Nat. _____

1st 24 hrs. after shot _____

Gas _____ Cu. Ft.


Dry Hole _____

Abandoned _____

Date

JUL 12 1950 19J. E. TYRA Scout

County Barton State Kansas
 Sec. 10 (Blk.) 18 (Sur.) 14W Map No.
 Operator Harbar Drlg.
 Well No. 1 Farm Dietz
 Elev. 1924 Location NE SE NE

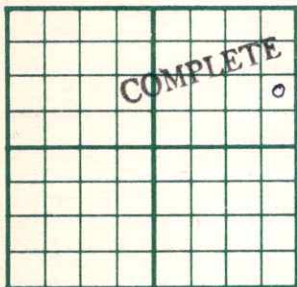

990 Ft. From S Line NE
330 Ft. From E Line Quarter

1st. Report

Completion AUG 30 1950

Remarks

Boyd Pool

Spudding Date 7-8-50

Drlg. Data Oil well TD 3416
13" @ 159 Anhy 880 Arb. 3413-15
5" @ 3414 TD 3416 S/ 16 boph
Comp. 454 bopd

J. E. TYDA