


Section 10 Township 18 Range 11 W

Well No. #2 Dietz

Company Harbar Drlg.

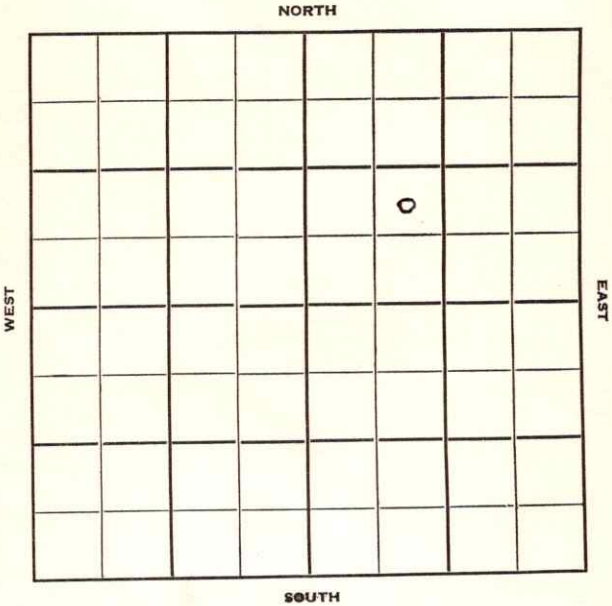

Barton

KANSAS

Sec. 10 Twp. 18 R. 14W

Well No. #2 Dietz Farm

Harber Drlg.

Company

Boyd Pool

Contractor

Ft. from N. Line

990'


Ft. from S. Line

Ft. from E. Line

990'

Ft. from W. Line

NE SW NE

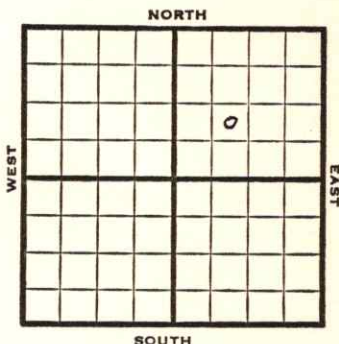

SOUTH

1951

Elev. 1929'

REPORT

1/17

Location

4/11

Oil well TD 3434'

Anhy 910', 13" @ 168'

Heeb 3096', Toronto 3106',

Lans 3178', Cong 3380', Arb 3423-31'


5" @ 3428' TD 3434'

Perf/ 3424-31

Comp. 223 BOPD

COMPLETED

County Barton State Kansas
 Sec. 10 (Blk.) 18 (Sur.) 14W Map No.
 Operator Harbar Drlg.
 Well No. 2 Farm Dietz
 Elev. 1929 Location NE SW NE

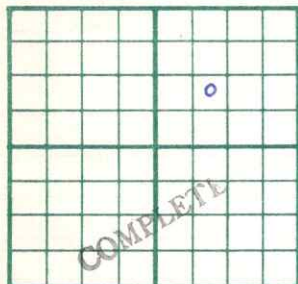

990 Ft. From S Line NE
990 Ft. From W Line Quarter
 1st. Report
 Completion APR 11 1951
 Remarks Boyd Pool
 Spudding Date

Drlg. Data Oil well TD 3434
Anhy 910 13" @ 168 Heeb. 3096
Toronto 3106 Lans. 3178 Cong. 3380
Arb. 3423-31 5" @ 3428 TD 3434
Perf/ 3424-31 Comp. 223 bopd

J. E. TYRA