


Section 21 Township 31 Range 4-E

Well No. #9 Waite

Company W. L. Hartman & Blair

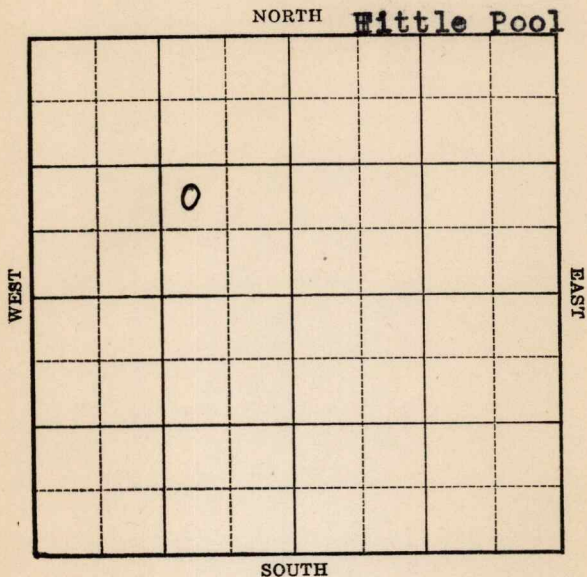

Sec. 21 Twp. 31 R. 4-E

Well No. #9 Waite Farm

W. L. Hartman & Blair Company


(Hittle)

_____ Ft. from N. Line

990 Ft. from S. Line

990 Ft. from E. Line

_____ Ft. from W. Line

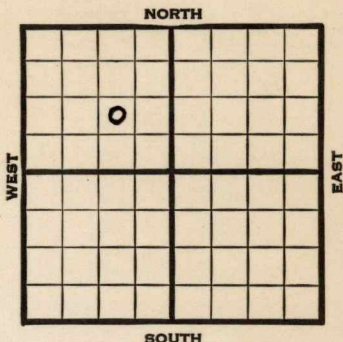

Elev. 1262

1939	REPORT
5/31	Rotary.
6/8	Surface hole
6/16	10" - 90' Drlg. 2545'
6/23	T.D. 3360' 7" - 3359' RUST. Miss. 3032'
6/28	Arb. 3368'
	7" - 3359'
	T.D. 3380'
	Bottom hole pressure
	bomb potential 5985 bbls.
	Maximum 3500 bbls.
	COMPLETED

Map No. _____ Sec. **21** Twp. **31** R. **4E**

Well No. **9 Waite**

W. L. Hartman & Blair Company

Contractor

FIRST REPORT

NW SE NW

SECTION PLAT

	0		

_____ Ft. from N. Line

990 Ft. from S. Line

990 Ft. from E. Line

_____ Ft. from W. Line

HITTLE POOL

Location _____

RECORD

Rig up _____

Cased _____ in., _____ ft.

Drilling and Remarks:

Sand _____

ROTARY

Gas _____

Oil _____

Total Depth _____

PRODUCTION

1st 24 hrs. Nat. _____

1st 24 hrs. after shot _____

Gas _____ Cu. Ft.

Dry Hole _____

Abandoned _____

Date

MAY 31 1939 19 _____

S. J. LEWIS Scout

