

Section 10 Township 18 Range 14-WWell No. #4 EveleighCompany Lewis Drlg.

NORTH

						0	

WEST

EAST

SOUTH

KANSAS

Barton

Sec. 10 Twp. 18 R. 14-W 

Well No. #4 Eveleigh Farm

Lewis Drlg.

Company

Lewis Drlg.

Contractor

Boyd
990

Ft. from N. Line


Ft. from S. Line

990

Ft. from E. Line

Ft. from W. Line

SW NE NE

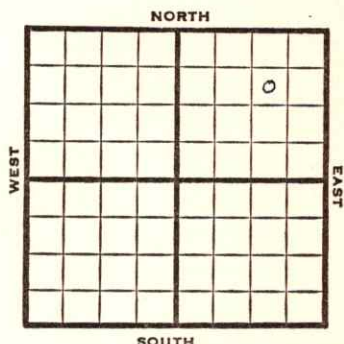

1950

Elv. 1937'

REPORT

11/8

Spud 11-4-50

8" @ 148

Anhy 885

Drlg 1890

12/6

Spud 11-4-50

Oil Well TD 3418

8" @ 148' Anhy 885'

Heeb. 3101' KC 3174'

SO 3182-94 3252-61 3368-71

Cong. 3396 Arb. 3409

SO 3410-12

5" @ 3410 TD 3418

FU 700' oil overnite S/28 boph

Comp. 794 bopd

COMPLETED

County Barton State KansasSec. 10 (Blk.) 18 (Sur.) 14W Map No.Operator Lewis Drlg.Well No. 4 Farm EveleighElev. Location SW NE NE


990 Ft. From N Line NE990 Ft. From E Line Quarter1st. Report NOV 8 1950

Completion

Remarks

Lewis Drlg. - Contr.Spudding Date 11-4-50Drlg. Data Boyd Pool8" @ 148 Anhy 885 drlg. 1890

County Barton State Kansas
 Sec. 10 (Blk.) 18 (Sur.) 14W Map No.
 (Twp.) (Rge.)
 Operator Lewis Drlg.
 Well No. 4 Farm Eveleigh
 Elev. 1937 Location SW NE NE

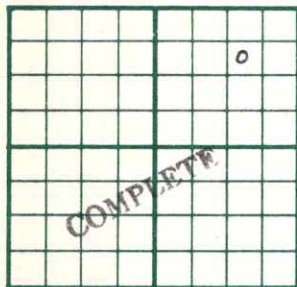

990 Ft. From N Line NE
990 Ft. From E Line Quarter
 Ist. Report
 Completion DEC 6 1950
 Remarks Boyd Pool
Lewis Drlg. - Contr.
 Spudding Date 11-4-50

Drlg. Data Oil well TD 3418
8" @ 148 Anhy 885 Heeb. 3101
KC 3174 SO 3182-84 3252-61 3368-71
Cong. 3396 Arb. 3409 SO 3410-12
5" @ 3410 TD 3418 FU 700' oil overnite
S/ 28 boph Comp. 794 bopd

J. E. TYRA