
FORM 51 25M 8-50 WESTERN

Barton KANSAS

Section 10 Township 18 Range 14W

Well No. #5 Eveleigh

Company Lewis Drlg.

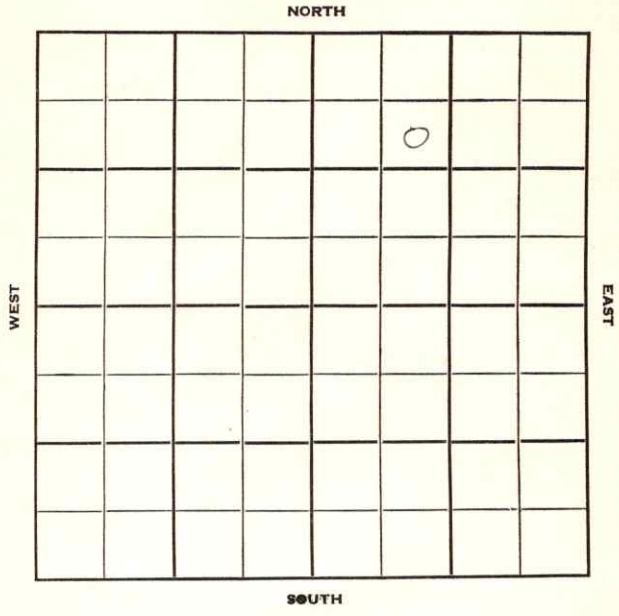

FORM 252-B
10M 10-50 PETROL

Barton KANSAS

Sec. 10 Twp. 18 R. 14W

Well No. #5 Eveleigh Farm

Lewis Drlg. Company

Lewis Drlg. - Contr.
Boyd Pool Contractor


990' Ft. from N. Line

Ft. from S. Line

Ft. from E. Line

990' Ft. from W. Line

SE NW NE

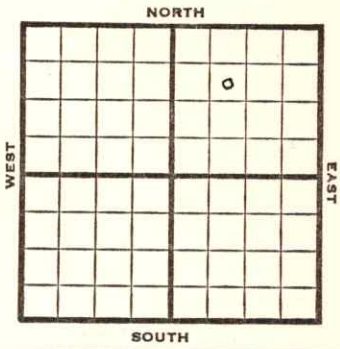

1950	Elev 1934' REPORT
11/29	Spud 11-25-50 8" @ 169' Anhy 890-915' Drlg. 1850'
1951 1/31	Spud 11/25/50 Oil well TD 3424 8" @169 Anhy 890-915 Heeb. 3094 Lans. 3168 Cong. 3383' Arb. 3412-14 5" @3412 TD 3424 S/ 2½boph 14/ 3417-24 200 A S/3 boph Comp. 390 bopd

COMPLETED

FORM 275 FOR SALE BY KANSAS BLUE PRINT CO.


County Barton State Kansas

Sec. 10 (Blk. Twp.) 18 (Sur. Rge.) 14W Map No.

Operator Lewis Drlg.

Well No. 5 Farm Eveleigh

Elev. 1934 Location SE NW NE

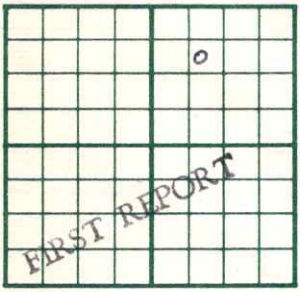

990 Ft. From N Line NE

990 Ft. From W Line Quarter

1st. Report NOV 29 1950

Completion

Remarks

Lewis Drlg. - Contr.

Spudding Date 11-25-50

Drlg. Data Boyd Pool

8" @ 169 Anhy 890-915 drlg. 1850

J. E. TYRA

FORM 275 FOR SALE BY KANSAS BLUE PRINT CO.

County Barton State Kansas

Sec. 10 (Blk. / Twp.) 18 (Sur. / Rge.) 14W Map No.

Operator Lewis Drlg.

Well No. 5 Farm Eveleigh

Elev. 1934 Location SE NW NE



990 Ft. From N Line NE

990 Ft. From W Line Quarter

1st. Report

Completion JAN 31 1951

Remarks Boyd Pool
Lewis Drlg. - Contr.

Spudding Date 11-25-50

Drlg. Data Oil well TD 3424

8" @ 169 Anhy 890-915 Heeb. 3094

Lans. 3168 Cong. 3383 Arb. 3412-14

5" @ 3412 TD 3424 S/ 2½ boph

14/ 3417-24 200 A S/ 3 boph

Comp. 390 bopd

J. E. TYRA