


Section 10 Township 18 Range 14W

Well No. #1 Eveleigh "B"

Company Grant Oil

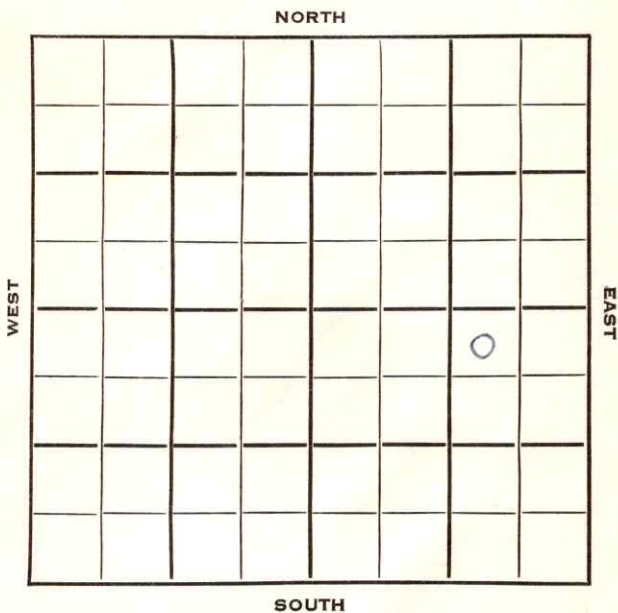

Barton **KANSAS** ✓

Sec. 10 Twp. 18 R. 14W

Well No. #1 Eveleigh "B" Farm

Grant Oil Company

Trans-Era Contractor

Boyd Pool


330 Ft. from N. Line

\_\_\_\_\_ Ft. from S. Line

990 Ft. from E. Line

\_\_\_\_\_ Ft. from W. Line

NW NE SE

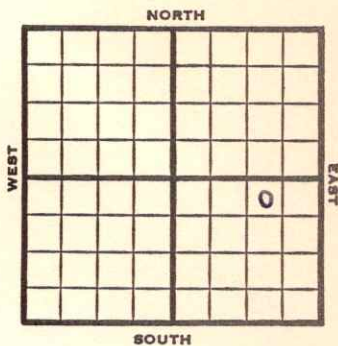

1953

**Elev. 1953' REPORT**

4/22 Spud 4-16-53  
8" @ 160  
**Anhy 910**  
Drlg. 2540'

4/29 Spud 4-16-53  
D & A  
TD 3493'  
8" @ 160'  
**Anhy 910, Heeb 3134, Tor 3146, Doug 3160, Lans 3208,**  
DST 3413-64 opn 3/4 hr. rec 20' mud  
105# **Arb 3469,**  
TD 3493'  
D & A

**ABANDONED**

County **Barton** State **Kansas**Sec. **10** (Blk.) **18** (Sur.) **14W** Map No.  
(Twp.) (Rge.)Operator **Grant Oil**Well No. **1** Farm **Eveleigh "B"**Elev. Location **NW NE SE**


**330** Ft. From **N** Line **SE****990** Ft. From **E** Line **Quarter**1st. Report **APR 22 1953**

Completion

Remarks

**Trans-Era - Cntr.**Spudding Date **4-16-53**Drlg. Data **Boyd Pool****8" @ 160 Anhy 910 drlg. 2540**

J. G. McGEHEE

County Barton State Kansas

Sec. 10 (Blk. Twp.) 18 (Sur. Rge.) 14W Map No.

Operator Grant Oil

Well No. 1 Farm Eveleigh "B"

Elev. 1953 Location NW NE SE


330 Ft. From N Line SE

990 Ft. From E Line Quarter

1st. Report

Completion APR 29 1953

Remarks Boyd Pool

Trans-Era - Centr.

Spudding Date 4-16-53

Drlg. Data D &amp; A TD 3493

8" @ 160 Anhy 910 Heeb. 3134

Tor. 3146 Doug. 3160 Lans. 3208

DST 3413-64 open 3/4 hr. Rec. 20' mud

105# Arb. 3469 TD 3493

D &amp; A