


Section 10 Township 18 Range 11W
Well No. #2 Hamilton
Company Bennett & Roberts

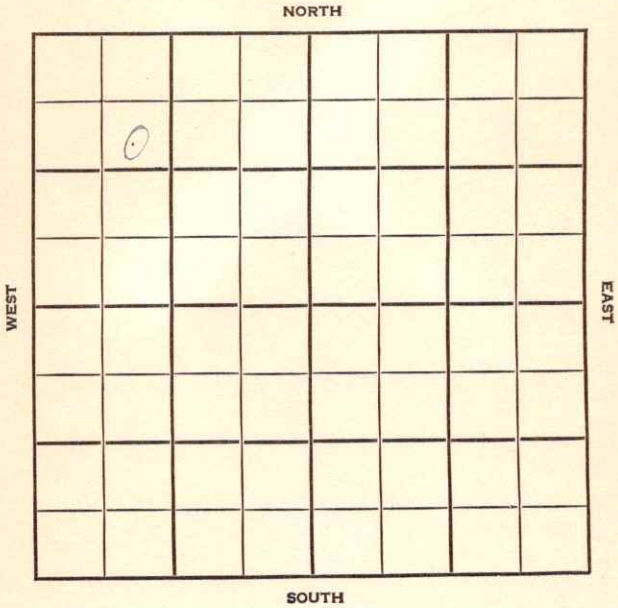

County Barton Elev. _____
 Sec. 10 Twp. 18 Rge. 11W
 Company Bennett & Roberts
 Farm Name Hamilton No. 2

TOPS	DEPTH	LOG	DATUM	Loc. in Sec.
Anh.				
Tr.				SE NW NW
H.	2910			
Tr. Dodge	2930			
Dg.	2945			
BL.	3019			
L.				
K.C.	3032			Geol. _____
B.K.C.				Contr. _____
Ce.				Co. tools
C.				Pool <u>Bloomer</u>
M.				<u>Claflin</u>
M.				
K.				
Mz.				
Me.				
V.				
S.				
S.				
A.				
R.				
Pe.				
G.				
T.D.				

FIRST REPORT

JAN 9 57

Date Comm. 1-1-57
8" @250/150 drlg. 3060

County Barton Elev. 1792
 Sec. 10 Twp. 18 Rge. 11W
 Company Bennett & Roberts
 Farm Name Hamilton No. 2

TOPS	DEPTH	LOG	DATUM	Loc. in Sec.
Anh.				SE NW NW
Tr.				
H.	2910			
Tr. Dodge	2930			
Dg.	2912			
Bl.	3019			
L.				Geol.
K.C.	3032			Contr.
B.K.C.				Co. tools
Ce.				Pool <u>BLOOMER</u>
C.				Clafin
M.				
M.				
K.				
Mz.				
Me.				
V.				
S.				
S.				
A.	3314			
R.				
Pe.				COMPLETE
G.				FEB 13 '57
T.D.	3324			

Date Comm. 1-4-57
 8" @250/150 drlg. 3060

5 1/2 @ 3320 / co 3324 1 1/2
& 11 Goph. Jan 23 '57 Frac &
27 B0 + 88 BW 12 hrs POP
JAN 30 '57 FEB 6 '57 FEB 13 '57 P. 25 BOPD
+ 50 Bwpd.