

KANSAS

FORM 51 5M 10-41 PETROL


Cowley

Section 23 Township 31 Range 4-E

Well No. #1 Franks Estate

Company Trees Oil

NORTH Deickman Pool

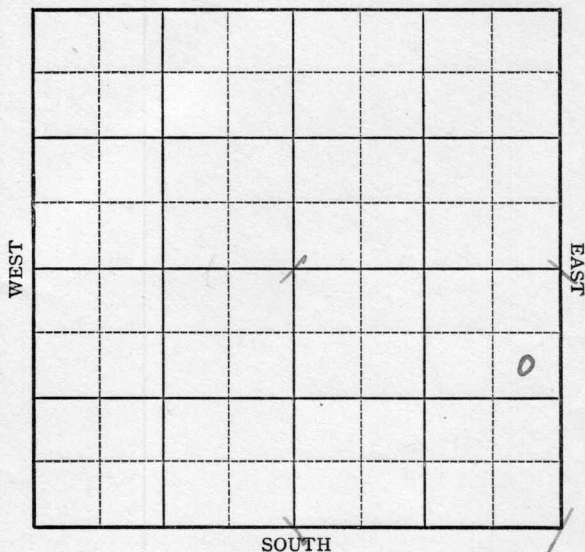

1942

6/10

Bart. 2860'

5" - 2822'

T.D. 2894'

Shot 60 qts. 2862-94'

Potential 938 bbls., flow.

40.2 Gravity

COMPLETED

Map No. 2 Sec. 23 Twp. 31 R. 4EWell No. 1 Franks Estate


Trees Oil

Company

FIRST REPORT

Contractor

SE NE SE

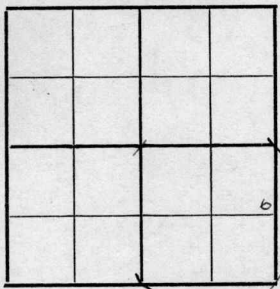SECTION PLAT990 Ft. from N. Line Ft. from S. Line330 Ft. from E. Line Ft. from W. Line

DEICKMAN POOL

Location XXXRig up

Drilling and Remarks:

RECORDCased in., ft.Sand Gas Oil Total Depth **PRODUCTION**1st 24 hrs. Nat. 1st 24 hrs. after shot Gas Cu. Ft.Dry Hole Abandoned

Date

MAR 1 8 1942

19

S. J. LEWIS

Scout

Cowley

KANSAS

Map No. 2 Sec. 23 Twp. 31 R. 4EWell No. 1 Franks Estate

Trees Oil

Company

COMPLETED

Contractor

SE NE SE

SECTION PLAT

990 Ft. from N. Line Ft. from S. Line330 Ft. from E. Line Ft. from W. Line

DEICHMAN POOL

RECORD

Location Cased in., ft.Rig up Sand

Drilling and Remarks:

Gas Oil Total Depth 2884

PRODUCTION

1st 24 hrs. Nat. 1st 24 hrs. after shot Gas Cu. Ft.Dry Hole Abandoned

Date

JUN 10 1942

19

S. J. LEWIS

Scout