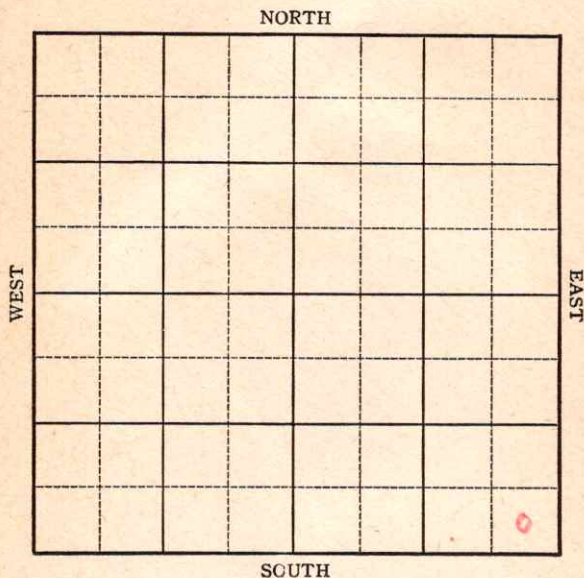


Section 10 Township 18 Range 11WWell No. #1 MusenbergCompany Kingwood Oil et al

KANSAS

Barton

Sec. 10 Twp. 18 R. 11W

Well No. #1 Musenberg Farm
Kingwood Oil et al Company


Wildcat

 Ft. from N. Line

330 Ft. from S. Line

330 Ft. from E. Line

 Ft. from W. Line

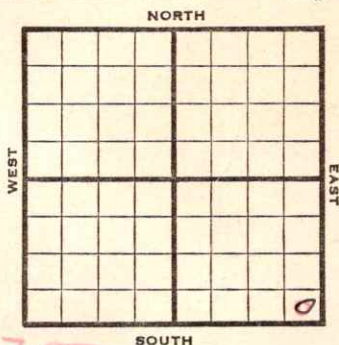

SE/c

800. 1775

1945

R E P O R T

2/21	Location	
2/28	8" @ 210	
	Drlg 750	
3/7	Anhy 680	
	Drlg 2810	
3/14	Lans	3028
	Cong	3300
	Arb.	3340
	TD	3400

ABANDONED

Pool Name WildcatMap No. 55 Sec. 10 Twp. 18 R. 11WWell No. 1 MusenbergKingwood Oil Etal


Company

FIRST REPORT

Contractor

SE/c

SECTION PLAT

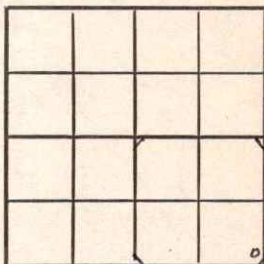 Ft. from N. Line330 Ft. from S. Line330 Ft. from E. Line Ft. from W. LineBarton County

RECORD

Location XCased in., ft.Rig up Sand

Drilling and Remarks:

Gas Oil Total Depth

PRODUCTION

1st 24 hrs. Nat. 1st 24 hrs. after shot Gas Cu. Ft.Dry Hole Abandoned

Date


FEB 21 194519S. J. LEWIS

Scout

Pool Name WildcatMap No. 55 Sec. 10 Twp. 18 R. 11WWell No. 1 MusenbergKingwood Oil etal CompanyABANDONED Contractor

SE/c

SECTION PLAT

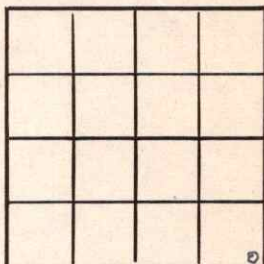 Ft. from N. Line330 Ft. from S. Line330 Ft. from E. Line Ft. from W. LineBartonLocation Rig up

Drilling and Remarks:

Louis 3028
Crug 3300
Cr 3340

RECORD

Cased in., ft.Sand Gas Oil Total Depth 3400

PRODUCTION

1st 24 hrs. Nat. 1st 24 hrs. after shot Gas Cu. Ft.Dry Hole Abandoned

Date

MAR 14 1945

19

S. J. LEWIS

Scout