

Barton
18

KANSAS

11W

Sec. 11 Twp. R. 11W

Well No. #1 Grizzell Farm

Branine & Holl Company

Atlas - Contr. Contractor
Rose Marie Pool


Ft. from N. Line

330' Ft. from S. Line

330' Ft. from E. Line

Ft. from W. Line

SE SE SW

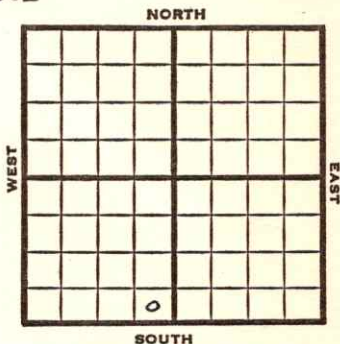

1951

Elev. 1790'

REPORT

4/18 Pits

5/16 Spud 4-26-51

D & A TD 3337' 8" @ 254'

Heeb 2903' Lans. 3032' Arb. 3321'

DST 3323-30 open 1/2 hr. rec 12' mud

TD 3337' D & A

ABANDONED

