

Sec. 21 Twp. 31 R. 4-E

Well No. #1 Hittle (Twin Well) Farm

Cities Service Oil Company


(Hittle)

990 Ft. from N. Line

_____ Ft. from S. Line

1020 Ft. from E. Line

_____ Ft. from W. Line

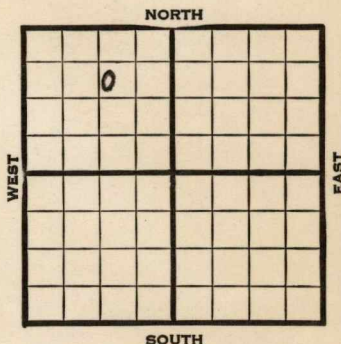

1939	REPORT
7/5	Location
7/13	Rotary.
7/20	10" - 129' Stalnacker 1986' Drlg.
7/27	K. C. 2420' Miss. 3030' Drlg. 3215'
8/3	Arb. 3371' T.D. 3378½' H.F.O. 3½ hours. Flow 100 bbls. per hour.
8/10	S.D.
8/16	Arb. 3371' 7" - 3370½' T.D. 3378½' Bottom hole pressure bomb potential 2606 bbls.
	COMPLETED

Map No. 2 Sec. 21 Twp. 31 R. 4E

Well No. 1 Hittle (Twin Well)

Cities Service Oil Company

Contractor

FIRST REPORT

SECTION PLAT

SW NE NW

990 Ft. from N. Line

_____ Ft. from S. Line

1020 Ft. from E. Line

_____ Ft. from W. Line

	o		

HITTLE POOL

Location X

Rig up _____

Drilling and Remarks:

RECORD

Cased _____ in., _____ ft.

Sand _____

Gas _____

Oil _____

Total Depth _____

PRODUCTION

1st 24 hrs. Nat. _____

1st 24 hrs. after shot _____

Gas _____ Cu. Ft.

Dry Hole _____

Abandoned _____

Date

JUL 5 1939 19

S. J. LEWIS

Scout

Cowley

KANSAS

Map No. 2 Sec. 21 Twp. 31 R. 4E

Well No. 1 Hittle (Twin Well)

Cities Service Oil Company

Contractor

COMPLETED

SECTION PLAT

990 SW NE NW
Ft. from N. Line

_____ Ft. from S. Line

1020 Ft. from E. Line

_____ Ft. from W. Line

HITTLE POOL

	o		

Location _____

Rig up _____

Drilling and Remarks:

*all 3371
7" @ 3370 1/2*

Bottom Hole Pressure

Born 2606

RECORD

Cased _____ in., _____ ft.

Sand _____

Gas _____

Oil _____

Total Depth 3378 1/2

PRODUCTION

1st 24 hrs. Nat. _____

1st 24 hrs. after shot _____

Gas _____ Cu. Ft.

Dry Hole _____

Abandoned _____

Date

AUG 16 1939 19

S. J. LEWIS Scout