



Sec. 21 Twp. 31 R. 4-E

Well No. ~~#1~~ C. Hittle #3 Farm

McKnab & Blair Company


(Hittle)

330 Ft. from N. Line

\_\_\_\_\_ Ft. from S. Line

\_\_\_\_\_ Ft. from E. Line

382 Ft. from W. Line

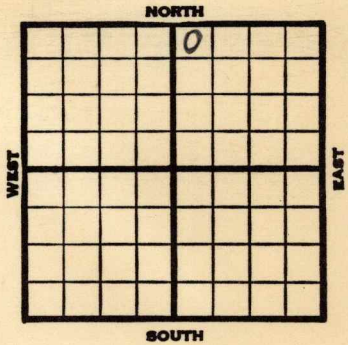

1939	REPORT
11/8	10" - 110'
	Drlg. 2255'
11/16	K. C. 2387' Miss. 2996'
	Drlg. 3165'
11/23	7" - 3345' Arb. 3360'
	T.D. 3364' H.F.O. 5 hours.
11/28	Arb. 3360'
	7" - 3345'
	T.D. 3364'
	Flow & Pump 918 bbls. Potential
	<b>COMPLETED</b>

Map No. 2 Sec. 21 Twp. 31 R. 4E

Well No. 4 C. Hittle

McKnab & Blair

Company

Contractor

FIRST REPORT

NW NE

SECTION PLAT

		0	

330 Ft. from N. Line

\_\_\_\_\_ Ft. from S. Line

\_\_\_\_\_ Ft. from E. Line

382 Ft. from W. Line

HITTLE POOL

Location \_\_\_\_\_

Rig up \_\_\_\_\_

Drilling and Remarks:

10" - 110  
Drlg. 2255

RECORD

Cased \_\_\_\_\_ in., \_\_\_\_\_ ft.

Sand \_\_\_\_\_

Gas \_\_\_\_\_

Oil \_\_\_\_\_

Total Depth \_\_\_\_\_

PRODUCTION

1st 24 hrs. Nat. \_\_\_\_\_

1st 24 hrs. after shot \_\_\_\_\_

Gas \_\_\_\_\_ Cu. Ft.

Dry Hole \_\_\_\_\_

Abandoned \_\_\_\_\_

Date

NOV 8 1939

S. J. LEWIS

Scout

Cowley

KANSAS

Map No. 2 Sec. 21 Twp. 31 R. 4E

Well No. 3 C. Hittle

McKnab & Blair Company

CORRECTION Contractor

SECTION PLAT

NW NE

330 Ft. from N. Line

\_\_\_\_\_ Ft. from S. Line

\_\_\_\_\_ Ft. from E. Line

382 Ft. from W. Line

		o	

HITTLE POOL

Location \_\_\_\_\_

Rig up \_\_\_\_\_

Drilling and Remarks:

Reported as #4

RECORD

Cased \_\_\_\_\_ in., \_\_\_\_\_ ft.

Sand \_\_\_\_\_

Gas \_\_\_\_\_

Oil \_\_\_\_\_

Total Depth \_\_\_\_\_

PRODUCTION

1st 24 hrs. Nat. \_\_\_\_\_

1st 24 hrs. after shot \_\_\_\_\_

Gas \_\_\_\_\_ Cu. Ft.

Dry Hole \_\_\_\_\_

Abandoned \_\_\_\_\_

Date

NOV 22 1939 19

S. J. LEWIS Scout

Map No. 2 Sec. 21 Twp. 31 R. 4E

Well No. 3 C. Hittle

McKnab & Blair

Company

Contractor

COMPLETED

SECTION PLAT

NW NE

330 Ft. from N. Line

\_\_\_\_\_ Ft. from S. Line

\_\_\_\_\_ Ft. from E. Line

382 Ft. from W. Line

		0	

HITTLE POOL

Location \_\_\_\_\_

Rig up \_\_\_\_\_

Drilling and Remarks:

*Cur 3360*

*7" @ 3345*

*Flow & Pump. 9/18/39*

RECORD

Cased \_\_\_\_\_ in., \_\_\_\_\_ ft.

Sand \_\_\_\_\_

Gas \_\_\_\_\_

Oil \_\_\_\_\_

Total Depth 3364

PRODUCTION

1st 24 hrs. Nat. \_\_\_\_\_

1st 24 hrs. after shot \_\_\_\_\_

Gas \_\_\_\_\_ Cu. Ft.

Dry Hole \_\_\_\_\_

Abandoned \_\_\_\_\_

Date

NOV 28 1939

S. J. LEWIS

Scout