


Section 12 Township 18 Range 11W

Well No. #7 Hertach

Company Woodriver Oil & Refining.

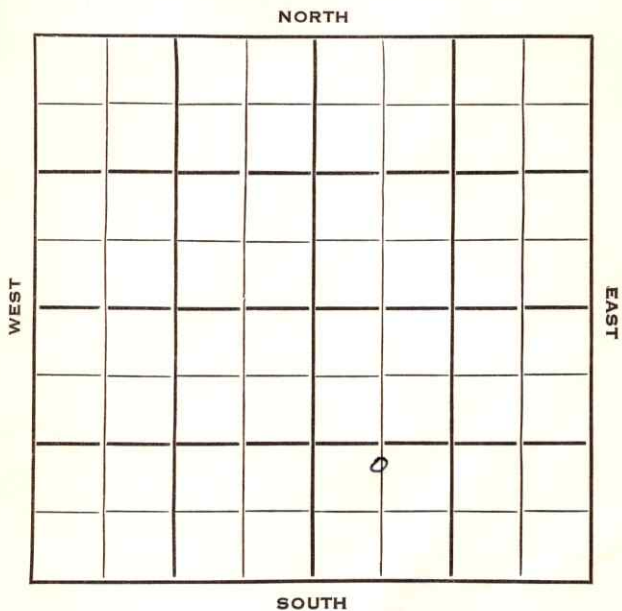

Sec. 12 Twp. 18 R. 11 WWell No. # 7 Hertach Farm _____Woodriver Oil & Ref. Company _____

Contractor _____


_____ Ft. from N. Line

990 Ft. from S. Line

_____ Ft. from E. Line

660 Ft. from W. Line

C N L SW SE

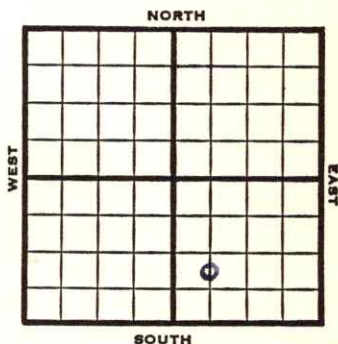1953 **Elev. 1784'** REPORT2/25 Spud 2-20-53
8" @ 254
Drlg. 1995'3/12 **Lans 2790' Arb. 3287**
DST 3255-82, 1 hr, 12' M plus 6' free
oil 180# RTD 3290 5" @ 3290
DD 3303' TD S/1/2 BOPH 500 A

3/19 36 BOPD POP

3/26 P/2 BOPH

4/2 "

4/9 P/36 BOPD

4/16 NR

4/22 Spud 2-20-53 Oil well TD 3303'
8" @ 254 **Lans. 2990 Arb. 3287**
TD 3290 5" @ 3290
DST 3255-82 open 1 hr. rec 12' mud.
6' free oil 180# DD 3303
S/1/2 BOPH 8 hr. 500 A 36 BOPD
P/2 BOPH P/36 BOPD
Comp. 6 BOPD**COMPLETED**

