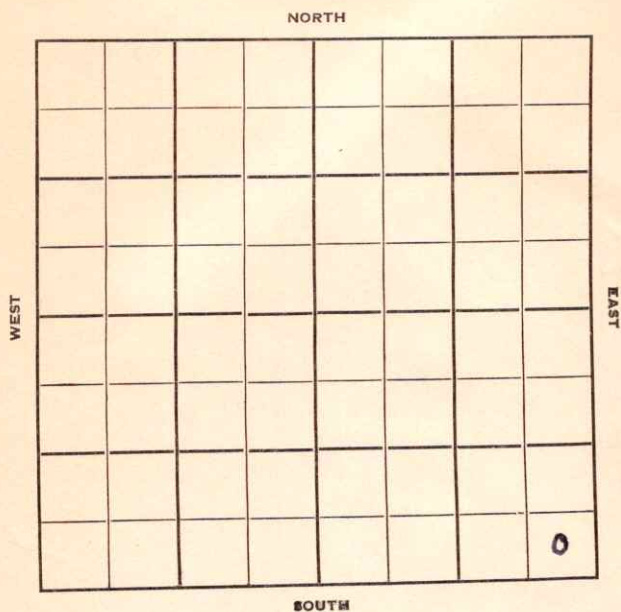


Barton

KANSAS

Section 12 Township 18 Range 11 WWell No. # 5 HertochCompany Woodriver Oil & Ref.

Barton

KANSAS

Sec. 12 Twp. 18 R. 11W

Well No. #5 Hertoch Farm

Woodriver Oil & Ref. Company

Contractor


Ft. from N. Line

330 Ft. from S. Line

330 Ft. from E. Line

Ft. from W. Line

SE SE SE

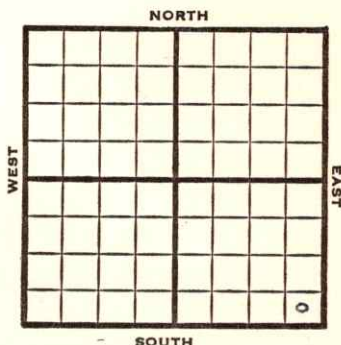

1952

Elev. 1779'

REPORT

10/1

Spud 9-28-52
8" @ 248
Drlg. 427

10/8

Topeka 2651, Heeb 2862, Br L. 2979,
Lans 2992'

10/15

DST 3210-16 1 hr., 30' O&GCM
Sand 3285, Arb 3310-20 TD
5" @ 3312

10/23

72/3287-99 SSO PB 3283½'
47/3208-16 1000 A Sq. off

10/29

PB 3046'
24/3016-21 wtr, sq off CO
23/3016-21, 1 BOPH & 3 BWPH

11/5

PDP

11/12

P/43 BOPD plus 50% wtr.

11/21

Spud 9-28-52 Oil well TD 3320'
8" @ 248 **Top. 2651' Heeb 2862'**
Br. lime 2979' Lans. 2992'
DST 3210-16 open 1 hr. rec 30' O &
WCM **Sand 3285' Arb. 3310'**
TD 3320' 5" @ 3312 72/3287-99 SSO
PB 3283' 47/3208-16 1000 A
PB 3046 24/3016-21 1 BOPH
3 BW P/43 BOPD 50% water.
Comp. 24 BOPD 96 BW

COMPLETED

