


Section 12 Township 18 Range 11W

Well No. #2 Miller

Company N.C.R.A.

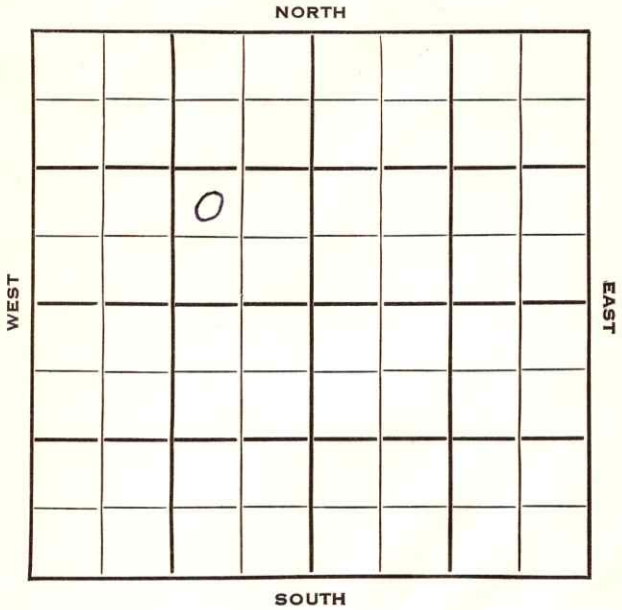

Barton


KANSAS

Sec. 12 Twp. 18 R. 11 WWell No. # 2 Miller Farm __________
NCRA Company_____
Ash-Mar Contractor

Sadie Pool

Ft. from N. Line990 Ft. from S. Line990 Ft. from E. Line_____
Ft. from W. Line

NW SE NW

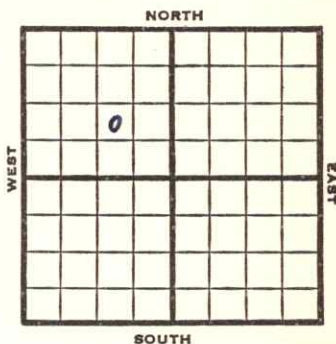

1953

Elev. 1770'

REPORT

8/19

Spud 8-15-53
8" @ 267' WOC

8/26

Anhy 560' Heeb 2869' Br li 2983'
Lans 2998'
Drlg. 3 265'

9/2

Arb 3281
DST 3282-84 2 hrs, 3' Oil, 5' M 720#
RTD 3284
5" @ 3281'
CO 3284
1 gwph / SSO 7 Hrs.
250 A/

9/9

S 2 boph 5 Hrs. B/ 2 1/2 BO 1/2 hr, POP

9/16

NR

9/23

Spud 8-15-53
Oil Well
TD 3284'
8" @ 267'
Anhy 560, Heeb 2869, Br. Lime 2983,
Lans 2998, Arb 3281,
DST 3288-84 opn 2 hr, rec 3' oil,
5' mud, 720#
TD 3284'

OVER

1953

Information brought forward.

9/23

5" @ 3281'

CO to 3284

1 gwph & SSO 7 hr.

250 A

S/ 2 boph 5 hr. B/ $2\frac{1}{2}$ bo $\frac{1}{2}$ hr.

Comp. 113 bopd.

COMPLETED

