


Section 23 Township 31 Range 4E

Well No. #3, Miller

Company Trees Oil

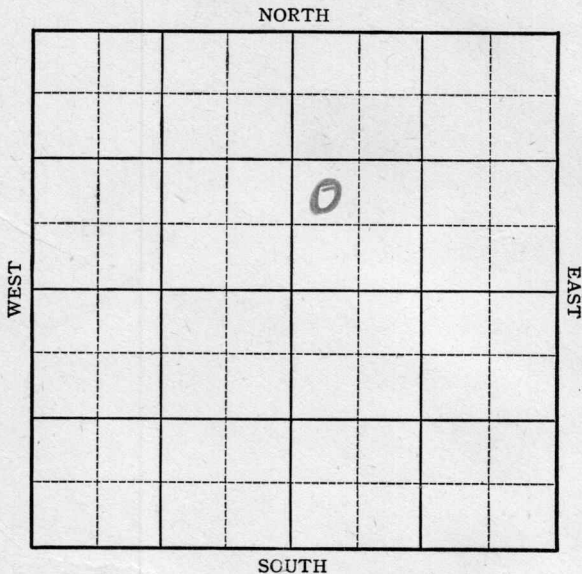


Sec. 23 Twp. 31 R. 4E

Well No. #3 Miller Farm \_\_\_\_\_  
Trees Oil Company \_\_\_\_\_

Miscellaneous

\_\_\_\_\_ Ft. from N. Line  
990 \_\_\_\_\_ Ft. from S. Line  
\_\_\_\_\_ Ft. from E. Line  
330 \_\_\_\_\_ Ft. from W. Line

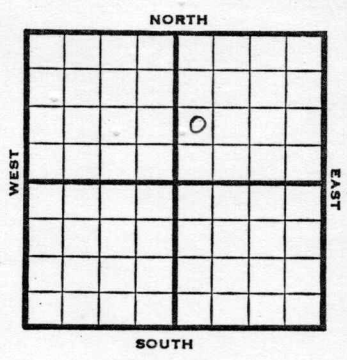

NW SW NE

1946 Elev. 1240

REPORT

- 4/17 Location
- 4/23 Rig
- 5/1 "
- 5/7 Drlg 300'
- 5/14 15" @ 355  
Drlg 1100'
- 5/21 Drlg 1550'
- 5/29 10" @ 1691  
Drlg. 1895'
- 6/5 TD 2140 Run 8"
- 6/12 KC 2320'  
Drlg 2555'
- 6/18 5" @ 2890  
Bart 2905'  
TD 2911'
- 6/26 TD 2957 C<sup>o</sup>
- 7/3 95 qts 2910-57 C<sup>o</sup>
- 7/3 " " "
- 7/16 " " "
- 7/23 " " "
- 7/30 " " "
- 8/6 " " "

OVER

1946

8/14 Bart. 2905  
5" @ 2890  
TD 2957'  
Pump 355 Pot.  
Grav. 40.0

COMPLETED

KANSAS

Kansas Pool Name Miscellaneous

Map No. 2 Sec. 23 Twp. 31 R. 4E

Well No. 3 Miller

Trees Oil Company

**FIRST REPORT** Contractor

NW SW NE

SECTION PLAT

\_\_\_\_\_ Ft. from N. Line

990 Ft. from S. Line

\_\_\_\_\_ Ft. from E. Line

330 Ft. from W. Line

		o	

Cowley County

Location X

Rig up \_\_\_\_\_

Drilling and Remarks:

RECORD

Cased \_\_\_\_\_ in., \_\_\_\_\_ ft.

Sand \_\_\_\_\_

Gas \_\_\_\_\_

Oil \_\_\_\_\_

Total Depth \_\_\_\_\_

PRODUCTION

1st 24 hrs. Nat. \_\_\_\_\_

1st 24 hrs. after shot \_\_\_\_\_

Gas \_\_\_\_\_ Cu. Ft.

Dry Hole \_\_\_\_\_

Abandoned \_\_\_\_\_

Date

APR 17 1946 19

S. J. LEWIS Scout

