


Section 12 Township 18 Range 11 W

Well No. #1 Roesler

Company N C R A

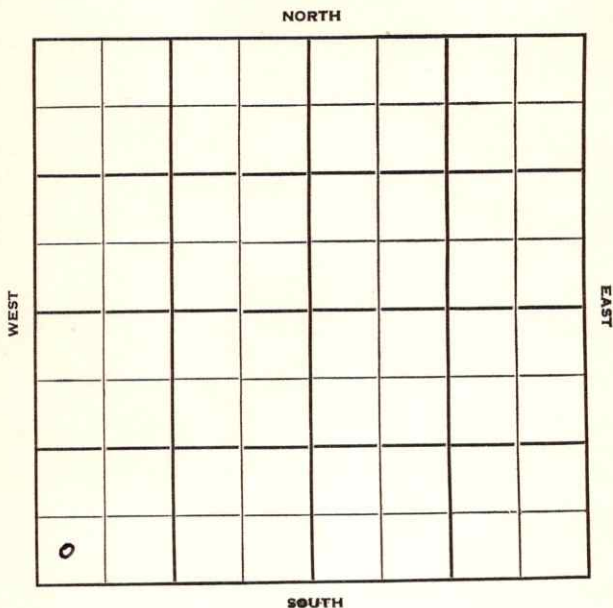

Barton **KANSAS**  
18 R. 11W ✓

Sec. 12 Twp. 18 R. 11W

Well No. #1 Roesler Farm

N C R A Company

Roesler Pool Contractor


Ft. from N. Line

330' Ft. from S. Line

Ft. from E. Line

330' Ft. from W. Line

SW SW SW

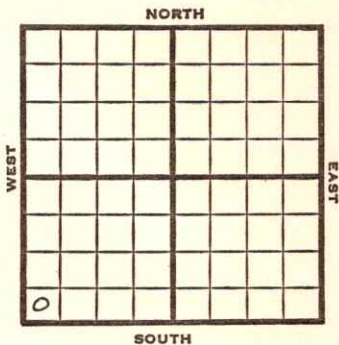

1951

**Elev. 1784'** REPORT

1/17

Location

2/14

Spud 1-18-51

Oil Well TD 3295

8" @ 252' **Anhy 580-610**

**Heeb. 2884' Dodge 2903**

**Br Lime 2999' Lans. 3015'**

**Cong. 3290' Arb. 3291-95'**

5" @ 3292' TD 3295'

FU 2742' oil 38 hr

Comp. 613 bopd

**COMPLETED**



