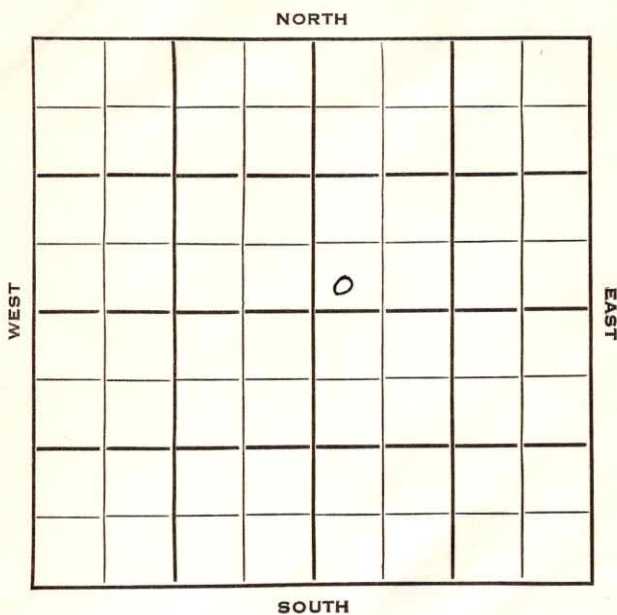


Section 12 Township 18 Range 11WWell No. #4 SmithCompany N C R A

Sec. 12 Twp. 18 R. 11W **KANSAS**Well No. #4 Smith FarmN C R A CompanyPan-Kar O - Contr. Contractor


Ft. from N. Line

330 Ft. from S. Line

Ft. from E. Line

330 Ft. from W. Line

SW SW NE

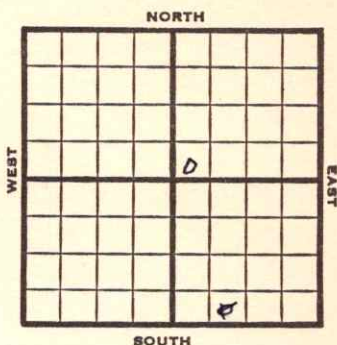

1953

Elev. 1769' REPORT

3/4 8" @ 248 WOC

3/12 Drlg. 2729'

3/19 **Heeb 2860' Lans 2990'**

DST 3273-81', 2 hrs, 2' oil, 28' gcm

60# **Arb. 3280'** RTD 3281'

5" @ 3280

3/26 CO 3281 SSO

DD 3282, FU 90' oil 80 mins.

S/1½ BOPH 4 hrs., S/2 BO 1 hr.

DD 3283, no inc.

S/1 BOPH

4/2 PB 3282' Hyd. S/3½ BOPH 7 hrs.

4/9 NR

4/16 NR

4/22 Spud 2-27-53 Oil well TD 3283

8" @ 248 **Anhy 568 Heeb 2860****Lans 2990**

DST 3273-81 open 2 hr rec 2' oil 28'

GCM 60# **Arb. 3280** TD 3281

5" @ 3280 CO to 3281 SSO DD 3282

FU 90' oil 80 min S/1½ BOPH 4 hr.


S/2 BO 1 hr. DD 3283 S/1 BO 1 hr.

PB 3282 Hydro S/3½ BOPH 7 hr.

Comp. 78 BOPD 3% wtr.

COMPLETED

County Barton State Kansas
 Sec. 12 (Blk. 18 (Sur. 11W Map No.
 (Twp.) (Rge.)
 Operator N C R A
 Well No. 4 Farm Smith
 Elev. 1769 Location SW SW NE

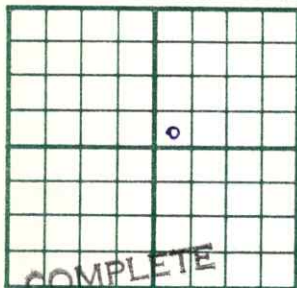

330 Ft. From S Line NE
330 Ft. From W Line Quarter

1st. Report

Completion APR 22 1953

Remarks

Pan-Kar - Contr.

Spudding Date 2-27-53

Drlg. Data Oil well TD 3283
8" @ 248 Anhy 568 Heeb. 2860
Lans. 2990 DST 3273-81 open 2 hr.
Rec. 2' oil 28' gcm 60# Arb. 3280
TD 3281 5" @ 3280 CO to 3281 SSO
DD 3282 FU 90' oil 80 min. S/ 1½ boph
4 hr. S/ 2 bo 1 hr. DD 3283
S/ 1 bo 1 hr. PB 3282 Hydro.
S/ 3½ boph 7 hr.
Comp. 78 bopd 3¾ wtr.

J. G. McGEREE