

Cowley


FORM 51 IOM 12-46 PETROL

KANSAS

Section 23 Township 31 Range 4E

Well No. 4 Deichman

Company Kanotex Ref.

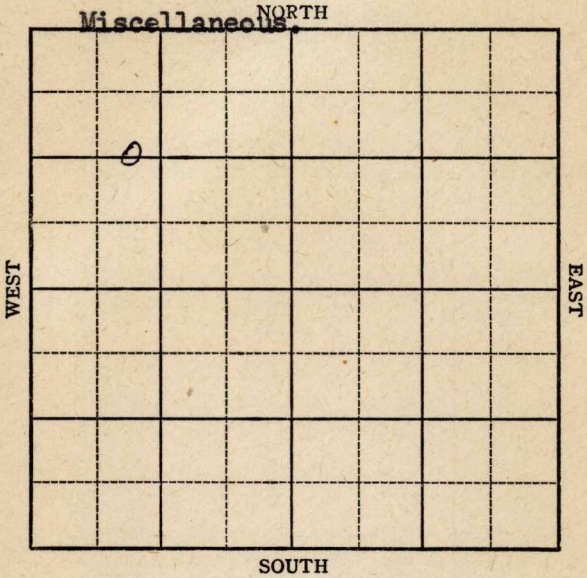

KANSAS

Cowley ✓

Sec. 23 Twp. 31 R. 4-E

Well No. #4 Deichman Farm

Kanotex Ref. Company


Miscellaneous

1320 Ft. from N. Line

_____ Ft. from S. Line

_____ Ft. from E. Line

990 Ft. from W. Line

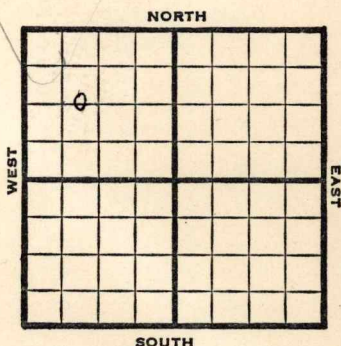

C E L $W\frac{1}{2}$ NW

1947 **Elev. 1302'** REPORT

- 4/30 R U R
- 5/7 8" @ 92'
Drlg. 1630'
- 5/13 **KC 2450'**
Drlg 2895'
- 5/20 " "
- 5/27 **Bart 2986**
TD 3015'
5" @ 2987'
- 6/4 **Bart. 2986'**
5" @ 2987'
Flow 200 Pot
38.0 Gr.
TD 3015'

COMPLETED

Kansas **KANSAS**

Map No. 2 Sec. 23 Twp. 31 R. 4E

Well No. 4 Deichman

Kanotex Ref. _____ Company _____

FIRST REPORT

Contractor _____

C E L W $\frac{1}{2}$ NW

SECTION PLAT

1320 Ft. from N. Line

_____ Ft. from S. Line

_____ Ft. from E. Line

990 Ft. from W. Line

Cowley County

Location _____

Rig up _____

Drilling and Remarks:

R U R

RECORD

Cased _____ in., _____ ft.

Sand _____

Gas _____

Oil _____

Total Depth _____

PRODUCTION

1st 24 hrs. Nat. _____

1st 24 hrs. after shot _____

Gas _____ Cu. Ft.

Dry Hole _____

Abandoned _____

Date

APR 30 1947 19

S. J. LEWIS Scout

Map No. 2 Sec. 23 Twp. 31 R. 4 E

Well No. 4 Deichman

Kanotex Ref. Company

COMPLETE

Contractor

C E L W $\frac{1}{2}$ NW

E 11302

SECTION PLAT

1320 Ft. from N. Line

_____ Ft. from S. Line

_____ Ft. from E. Line

990 Ft. from W. Line

Cowley County

RECORD

Location _____

Rig up _____

Drilling and Remarks:

Cased _____ in., _____ ft.

Sand _____

Gas _____

Oil _____

Total Depth 9015

Bar 2986
5' 2987
Flow 200 BX

3824

PRODUCTION

1st 24 hrs. Nat. _____

1st 24 hrs. after shot _____

Gas _____ Cu. Ft.

Dry Hole _____

Abandoned _____

Date

JUN 4 1947 19

S. J. LEWIS

Scout